

STATE OF KANSAS
STATE CORPORATION COMMISSION
200 Colorado Derby Bldg.
Wichita, Kansas 67202

Form CP-4
Rev. 12-15-80

WELL PLUGGING RECORD

Give All Information Completely
Make Required Affidavit

COUNTY Stafford SEC. 3 TWP. 25S RGE. 14W E/W
Location as in quarters or footage from lines:
C NE NE

Lease Owner F. G. Holl
Lease Name Dykes Well No. 1-3
Office Address 6427 East Kellogg, Wichita, Kansas 67207
Character of Well (Completed as Oil, Gas or Dry Hole): Dry Hole
Date Well Completed October 28, 1983
Application for plugging filed October 28, 1983
Plugging commenced 7:00 PM - October 28, 1983
Plugging completed 8:30 PM - October 28, 1983
Reason for abandonment of well or producing formation Dry Hole

Locate Well
correctly on above
Section Platt.

Was permission obtained from the Conservation Division or it's
Agent's before plugging was commenced? Yes

Name of Conservation Agent who supervised plugging of this well Richard Lacey

Producing formation _____ Depth to top _____ bottom T.D. 4390'
Show depth and thickness of all water, oil and gas formations.

OIL, GAS OR WATER RECORDS

Casing Record

Formation	Content	From	To	Size	Put in	Pulled Out
				8 5/8"	305'	None


Describe in detail the manner in which the well was plugged, indicating where the mud
fluid was placed and the method or methods used in introducing it into the hold. If cement
or other plugs were used, state the character of same and depth placed, from _____ feet
to _____ feet for each plug set.

Filled hole with heavy mud.
50 sacks at 870'; 40 sacks at 330';
solid bridge and plug with 10 sacks at 40';
10 sacks in mousehold; 10 sacks in rathole.
Total of 120 sacks of 60/40 Pozmix, w% gel
and 3% cc.

(If additional description is necessary, use BACK of this sheet)

Name of Plugging Contractor Sterling Drilling Company, P. O. Box 129, Sterling, Kansas 67579

STATE OF KANSAS COUNTY OF RICE, ss.
F. A. Wuellner (employee of owner) or (owner or operator) of the
above-described well, being first duly sworn on oath, says: That I have knowledge of the
facts, statements, and matters herein contained and the log of the above-described well as
filed and that the same are true and correct. So help me God.

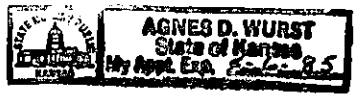

STERLING DRILLING COMPANY
(Signature) F. A. Wuellner
F. A. Wuellner, Secretary
(Address)

P. O. Box 129, Sterling, Ks. 67579

SUBSCRIBED AND SWORN TO before me this 31st day of October, 19 83.

My Commission expires: 4-6-85

Agnes D. Wurst
Agnes D. Wurst, Notary Public.

RECEIVED
STATE CORPORATION COMMISSION
NOV 3 1983
CONSERVATION DIVISION
Wichita, Kansas

11-3-83

STERLING DRILLING CO.

BOX 129

STERLING, KANSAS 67579

WELL LOG ----- DYKES #1-3
Located: C NE NE, Section 3-25S-14W, Stafford County, Kansas

OWNER: F. G. Holl

ROTARY DRILLING CONTRACTOR: Sterling Drilling Company

COMMENCED: October 20, 1983

COMPLETED: October 28, 1983

TOTAL DEPTH: 4390'

LOG

0 - 298 Sand, Shale and Red Bed
298 - 865 Shale
865 - 885 Anhydrite
885 - 4390' Lime and Shale

CASING RECORD

Ran 7 joints 8 5/8" casing. 283.08'
pipe set at 305' K.B. Cemented with
240 sacks 60/40 Pozmix, 2% gel and
3% cc. Plug down at 4:45 AM, 10-21-83,
by Howco.

Plugged.

Deviation Surveys: 3/4° at 2053'
1 1/4° at 3747'
1 3/4° at 4153'