


STATE OF KANSAS
STATE CORPORATION COMMISSION

Give All Information Completely
Make Required Affidavit
Mail or Deliver Report to:
Conservation Division
State Corporation Commission
800 Bitting Building
Wichita, Kansas

WELL PLUGGING RECORD
OR
FORMATION PLUGGING RECORD

Strike out upper line
when reporting plug-
ging off formations.

NORTH

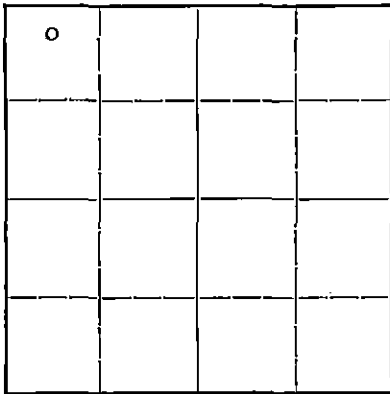

Locate well correctly on above
Section Plat

Stafford County. Sec. 5 Twp. 25 Rge. 14 (E) 14 (W)
Location as "NE $\frac{1}{4}$ NW $\frac{1}{4}$ SW $\frac{1}{4}$ " or footage from lines. Center N $\frac{1}{2}$ NW $\frac{1}{4}$ NW $\frac{1}{4}$
Lease Owner J. J. Lynn
Lease Name R. E. Wilson Well No. 1 A
Office Address 701 Bitting Bldg., Wichita, Kansas
Character of Well (completed as Oil, Gas or Dry Hole) Dry hole
Date, well completed December 15 19 41
Application for plugging filed December 16 19 41
Application for plugging approved December 22 19 41
Plugging Commenced December 17 19 41
Plugging Completed December 23 19 41
Reason for abandonment of well or producing formation Non productive

If a producing well is abandoned, date of last production 19
Was permission obtained from the Conservation Division or its agents before plugging was com-
menced? Application was filed

Name of Conservation Agent who supervised plugging of this well A. T. Alexander
Producing formation None Depth to top Bottom Total Depth of Well 4207 Feet
Show depth and thickness of all water, oil and gas formations.



OIL, GAS OR WATER RECORDS

CASING RECORD

Formation	Content	From	To	Size	Put In	Pulled Out
Lime	Light show oil	3923	3971	7	3948	2099
Lime	nothing	4092	4111	5 $\frac{1}{2}$	4103	3991
Shale shells	nothing	0	363	10	280	

Describe in detail the manner in which the well was plugged, indicating where the mud fluid was placed and the method or methods used in introducing it into the hole. If cement or other plugs were used, state the character of same and depth placed, from feet to feet for each plug set.

Plug back with mud from 4207 to 3975. Cement placed in hole with dump bailer from 3975 to 3945. Lead plug, lead wool and oakum from 3945' to 3940'. Hole filled with mud from 3940 to 275. Cement placed in hole with dump bailer from 275' to 255'. Hole filled with mud from 255' to 30'. Cement placed in hole with dump bailer from 30' to 8' and then filled with mud to surface

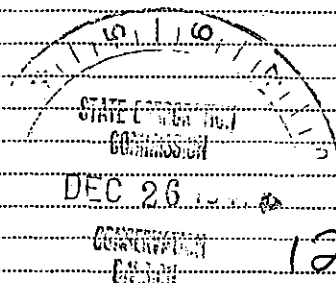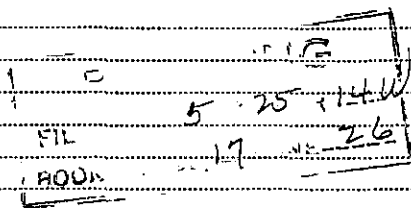

(If additional description is necessary, use BACK of this sheet)

Correspondence regarding this well should be addressed to J. J. Lynn
Address 701 C/O H. M. Williams, 701 Bitting Building, Wichita, Kansas

STATE OF Kansas, COUNTY OF Sedgwick, ss.
H. M. Williams (employee of owner) or (owner or operator) of the above-described well,
being first duly sworn on oath, says: That I have knowledge of the facts, statements, and matters herein contained and the log of the above-described well as filed and that the same are true and correct. So help me God.

(Signature) H. M. Williams
701 Bitting Bldg. Wichita, Kas.
(Address)

SUBSCRIBED AND SWORN to before me this 26th day of December, 1941

My commission expires Mar. 4-1944.

Notary Public.

WELL LOG

COMPANY	FARM NAME	WELL NO.	S.	T.	R.	LOCATION	COUNTY
J. J. Lynn	R. E. Wilson	1 A	5	25	14 W	CM $\frac{1}{4}$ NW $\frac{1}{4}$ NW $\frac{1}{4}$	Stafford
Drilling began May 31, 1941.		Completed December 16, 1941					
Rotary log from 0 to 3967.		Cable tool log from 3967 to 4207					

Sand and shale shells	363	Lime, chat & green shale	4105
red bed & shale	587	lime soft light (show oil)	4108
red bed & sand	887	lime gray hard	4111
shale & shells	1136	lime brown & green shale	4116
shale & shells	1320	lime	4119
shale & lime	1380	shale & red rock	4129
shale & shells	1885	lime	4134
broken lime	1970	shale	4140
lime	2025	lime (show light oil)	4167
shale & lime	2145	lime & shale	4170
broken lime	2200	lime	4181
lime & shale	2345	shale various colors	4205
broken lime	2427	shale & lime	4207
lime	2555		
red bed	2570	Total depth	4207
broken lime	2598		
lime & shale	2690		
lime	2727		
rough broken lime	2746		
lime & shale	2971		
broken lime & shale	3000		
lime & shale	3104		
shale	3135		
lime	3147		
shale	3196		
lime	3215		
lime & shale	3335		
lime	3376		
lime & shale	3485		
lime	3551		
lime & shale	3642		
broken lime & shale	3708		
lime	3746		
lime & shale	3837		
lime (cored 3841-3853)	3858		
lime & shale	3923		
lime (cored 3953-3967) show of oil	3971		
shale black (set 7" casg at 3948)	3973		
lime	4003	water at 3987	
shale	4006		
lime & shale	4010		
lime	4016		
shale	4022		
green shale & lime	4025		
lime	4026		
shale white	4027		
lime sandy	4030		
shale soft	4032		
red bed	4038		
lime	4045		
shale blue	4070		
lime hard	4072		
shale & lime shells	4081		
shale	4085		
shale & lime	4092		
lime (set 5" casing at 4103)	4104		

