


Give All Information Completely
Make Required Affidavit
Mail or Deliver Report to:
Conservation Division
State Corporation Commission
211 No. Broadway
Wichita, Kansas

WELL PLUGGING RECORD

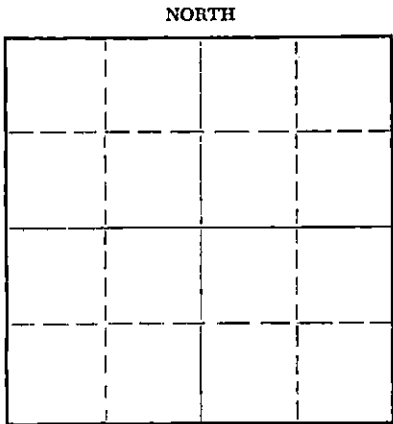

Locate well correctly on above
Section Plat

Pratt County, Sec. 21 Twp. 26 Rge. 15W (E) (W)
Location as "NE/CNW%SW%" or footage from lines SE SE SW
Lease Owner Morgenstern & Specter
Lease Name Eloit Well No. 1
Office Address Russell, Kansas
Character of Well (completed as Oil, Gas or Dry Hole) _____
Date well completed 4-17-55 19____
Application for plugging filed Dec. 1, 1963 19____
Application for plugging approved Dec. 2, 1963 19____
Plugging commenced January 31, 1964 19____
Plugging completed February 6, 1964 19____
Reason for abandonment of well or producing formation failure to produce profitably
If a producing well is abandoned, date of last production _____ 19____
Was permission obtained from the Conservation Division or its agents before plugging was commenced? Yes

Name of Conservation Agent who supervised plugging of this well Archie V. Elving Pratt, Kansas
Producing formation Kansas City Depth to top 3907 Bottom 4233 Total Depth of Well 4710 Feet
Show depth and thickness of all water, oil and gas formations.

OIL, GAS OR WATER RECORDS

CASING RECORD

FORMATION	CONTENT	FROM	TO	SIZE	PUT IN	PULLED OUT
				8 5/8" OD	272 ft.	none
				5 1/2" OD	4233 ft.	3113.38

Describe in detail the manner in which the well was plugged, indicating where the mud fluid was placed and the method or methods used in introducing it into the hole. If cement or other plugs were used, state the character of same and depth placed, from _____ feet to _____ feet for each plug set.

Plugged back with sand to, 3890-feet, dumped 5- sacks cement.
Set a rock bridge at 260-feet, dumped 25- sacks cement.
Set a rock bridge at 35- feet, dumped ten sacks cement.

RECEIVED
STATE CORPORATION COMMISSION

FEB 11 1964

CONSERVATION DIVISION
Wichita, Kansas

2-11-64

(If additional description is necessary, use BACK of this sheet)

Name of Plugging Contractor LYNCH CASING PULLING, COMPANY NO. 457
Address Rt. 4 GREAT BEND, KANSAS

STATE OF Kansas, COUNTY OF Russell, ss.
Morgenstern & Specter (employee of owner) or (owner or operator) of the above-described well, being first duly sworn on oath, says: That I have knowledge of the facts, statements, and matters herein contained and the log of the above-described well as filed and that the same are true and correct. So help me God.

(Signature) _____

Morgenstern & Specter
Russell, Kansas

(Address)

SUBSCRIBED AND SWORN TO before me this 10th day of February, 1964

Barbara Fortney (Krug)
Notary Public.

My commission expires Feb 29, 1964

WELL LOG BUREAU—KANSAS GEOLOGICAL SOCIETY
508 East Murdock, Wichita, Kansas

COPY

15-151-10915-0000

Company: LION OIL CO.
Farm: Elliot No. 1

SEC. 21 T. 26 R. 15W
SE SE SW

Total Depth. 4710
Comm. 3-30-55 Comp. 4-17-55
Shot or Treated.
Contractor. Garvey Drilling Co.
Issued. 7-2-55

County Pratt
KANSAS



8 5/8" @ 272' w/ 225 sx cmt.
5 1/2" @ 4233' w/ 200 sx cmt.

Elevation. 2052

Production. 431 BQ

Figures Indicate Bottom of Formations

sand & shale	272
shale & shells	948
red rock	1005
anhydrite	1045
red rock & shale	1235
shale & shells	1625
salt	1820
shale & shells	2005
lime	2040
Ft. Riley lime	2140
lime & shale	2400
lime	2450
lime & shale	3485
lime	3565
lime & shale	3735
lime	3830
lime & shale	3910
lime	4245
lime & conglomerate	4290
lime	4329
Mississippi lime & chert	4395
lime & shaley chert	4440
chert & lime	4488
cherty lime & shale	4555
cherty lime	4583
cherty lime & shale	4621
lime, shale & sand streaks	4653
shale	4685
Arbuckle	4705
lime & shale	4710
Total Depth	

SCOUT TOPS:

Heebner	3733
Lansing	3907
Base KC	4233
Mississippi	4327
Viola	4418
Simpson	4601
Arbuckle	4684

RECEIVED
STATE CORPORATION COMMISSION

DEC 2 1963

CONSERVATION DIVISION
Wichita, Kansas