


STATE OF KANSAS  
STATE CORPORATION COMMISSION

Give All Information Completely  
Make Required Affidavit  
Mail or Deliver Report to:  
Conservation Division  
State Corporation Commission  
211 No. Broadway  
Wichita, Kansas

WELL PLUGGING RECORD

Form CP-4  
15-151-19125-0000  
15-151-19125-0000

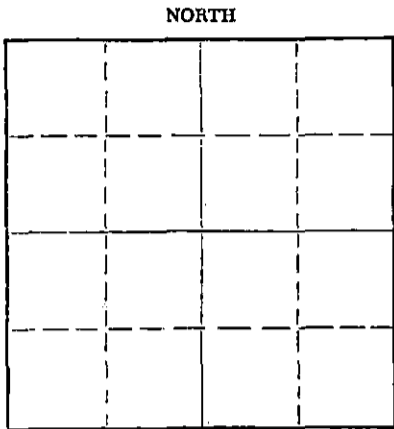

Locate well correctly on above Section Plat

Pratt County. Sec. 27 Twp. 26S Rge. (E) 15 (W)  
Location as "NE/CNW%SW%" or footage from lines NE NW SE  
Lease Owner Strata Drilling, Inc.  
Lease Name Tatlock Well No. 1  
Office Address P. O. Box 355, Great Bend, Kansas  
Character of Well (completed as Oil, Gas or Dry Hole) Dry Hole  
Date well completed May 24 1964  
Application for plugging filed May 24 1964  
Application for plugging approved May 24 1964  
Plugging commenced May 24 1964  
Plugging completed May 24 1964  
Reason for abandonment of well or producing formation Dry Hole

If a producing well is abandoned, date of last production 19  
Was permission obtained from the Conservation Division or its agents before plugging was commenced? Yes

Name of Conservation Agent who supervised plugging of this well Archie V. Elving, Pratt, Kansas  
Producing formation Depth to top Bottom Total Depth of Well 4468 Feet  
Show depth and thickness of all water, oil and gas formations.

OIL, GAS OR WATER RECORDS

CASING RECORD

FORMATION	CONTENT	FROM	TO	SIZE	PUT IN	PULLED OUT
		0	320'	10-3/4"		

Describe in detail the manner in which the well was plugged, indicating where the mud fluid was placed and the method or methods used in introducing it into the hole. If cement or other plugs were used, state the character of same and depth placed, from feet to feet for each plug set.  
Plugged hole as follows: Plugged at 270' with 35 sacks of cement and 1/4 sack of hulls and mud to 35'; plugged with 15 sacks of cement and 1/4 sack of hulls. Plugged rat hole with with 2 sacks of cement and also put 2 sacks of cement in the mouse hole. Job completed at 1:00 A. M. May 24, 1964.

RECEIVED  
STATE CORPORATION COMMISSION

MAY 29 1964

CONSERVATION DIVISION  
Wichita, Kansas

5-29-64

(If additional description is necessary, use BACK of this sheet)  
Name of Plugging Contractor Strata Drilling, Inc.  
Address P. O. Box 355, Great Bend, Kansas

STATE OF KANSAS, COUNTY OF BARTON, ss.  
Charles W. Steincamp (employee of owner) or (owner or operator) of the above-described well, being first duly sworn on oath, says: That I have knowledge of the facts, statements, and matters herein contained and the log of the above-described well as filed and that the same are true and correct. So help me God.

(Signature) Charles W. Steincamp  
Charles W. Steincamp, President  
P. O. Box 355, Great Bend, Kansas  
(Address)

SUBSCRIBED AND SWORN TO before me this 27th day of May, 1964

My commission expires December 14, 1965

Elaine H. Taylor, Notary Public.

D R I L L E R S   L O G

#1 Tatlock

CASING RECORD:  
Ran 320' of, used 10-3/4"  
surface casing.

COMPANY: Strata Drilling, Inc.  
CONTRACTOR: Strata Drilling, Inc.

DESCRIPTION: NE NW SE  
Section 27-26S-15W  
Pratt County, Kansas

TOTAL DEPTH:  
4468'

COMMENCED: May 14, 1964  
COMPLETED May 24, 1964

ELEVATION: 2047' KB

D. & A.

15-151-19125-0000

<u>FORMATION</u>	<u>FROM</u>	<u>TO</u>	<u>REMARKS</u>
Sand & Clay	0	328	Ran 320' of used 10-3/4" surface casing; set and cemented at 328' with 350 sacks of common cement, 2% gel and 3% calcium chloride. Plug down at 5:00 A. M. May 15, 1964.
Red Bed	328	977	
Anhydrite	977	990	
Shale & Shells	990	1040	DST #1 3897'-3932' tool open 1 hour, gas to surface in 25 minutes. Recovered 800' heavy oil and gas cut mud and oil, 1640' oil and gas cut water. ISIP 1365 lbs. IFP 380 lbs. FFP 1075 lbs. FSIP 1245 lbs. in 20 minutes.
Shale	1040	1952	
Lime & Shale	1952	2214	DST #2 4040'-4056' tool open 50 minutes, weak blow for 15 minutes. Flushed tool. Recovered 15' mud. ISIP 1470 lbs. IFP 40 lbs. FFP 85 lbs. FSIP 1390 lbs. in 20 minutes.
Lime	2214	2440	
Lime & Shale	2440	3515	DST #3 4119'-4144' tool open 90 minutes, gas to surface in 55 minutes. Recovered 80' slightly oil cut mud, 90' heavy oil and gas cut mud. ISIP 1305 lbs. IFP 85 lbs. FFP 150 lbs. FSIP 675 lbs. in 30 minutes stilling building.
Shale w/Lime Streaks	3515	3680	
Lime & Shale, Sandy	3680	3820	DST #4 4440'-4468' tool open 1 hour, good blow. Recovered 744' salt water. ISIP 1575 lbs. IFP 90 lbs. FFP 415 lbs. FSIP 1545 lbs. in 20 minutes.
Shale	3820	3868	
Lime & Shale	3868	3932	D. & A.
Lime	3932	4185	
Lime & Shale	4185	4265	Plugged hole as follows: Plugged at 270' with 35 sacks of cement and 1/4 sack of hulls and mud to 35'; plugged with 15 sacks of cement and 1/4 sack of hulls. Plugged rat hole with 2 sacks of cement and also put 2 sacks of cement in the mouse hole. Job completed at 1:00 A. M. May 24, 1964.
Lime	4265	4309	
Lime, Shale & Chert	4309	4360	
Lime & Chert	4360	4402	
Lime	4402	4468	

Total Depth 4468'

**RECEIVED**  
STATE CORPORATION COMMISSION

MAY 29 1964

CONSERVATION DIVISION  
Wichita, Kansas

STATE OF KANSAS )  
                          ) ss.  
COUNTY OF BARTON )

I certify that this is a true and correct copy of the above log to the best of my knowledge.

STRATA DRILLING, INC.

*Charles W. Steincamp*  
Charles W. Steincamp, President

Subscribed and sworn to before me this 27th day of May, 1964.

My Commission Expires:  
December 14, 1965

*Elaine H. Taylor*  
Elaine H. Taylor, Notary Public