

STATE OF KANSAS
STATE CORPORATION COMMISSION

WELL PLUGGING RECORD

Give All Information Completely
Make Required Affidavit
Mail or Deliver Report to:
Conservation Division
State Corporation Commission
800 Bittling Building
Wichita, Kansas

Reno County, Sec. 14 Twp 23 Rge. 8 (E) 8 (W)

Location as "NE/CNW¹/₄SW¹/₄" or footage from lines Center NE NE NE

Lease Owner The Atlantic Refining Company

Lease Name Clyde C. Short Well No. 1

Office Address Box 17, Great Bend, Kansas

Character of Well (completed as Oil, Gas or Dry Hole) Dry Hole

Date well completed 8-14 19 51

Application for plugging filed 8-14 19 51

Application for plugging approved 8-15 19 51


Plugging commenced 8-20 19 51

Plugging completed 9-2 19 51

Reason for abandonment of well or producing formation

If a producing well is abandoned, date of last production 19

Was permission obtained from the Conservation Division or its agents before plugging was commenced? Yes

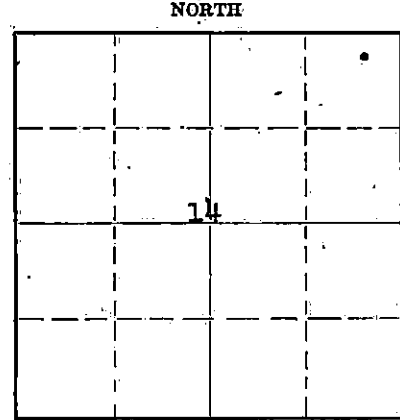

Locate well correctly on above Section Plat

Name of Conservation Agent who supervised plugging of this well

Producing formation Mississippi Lime Depth to top 3658 Bottom 3661 Total Depth of Well 4095 Feet

Show depth and thickness of all water, oil and gas formations.

OIL, GAS OR WATER RECORDS

CASING RECORD

Formation	Content	From	To	Size	Put In	Pulled Out
				9-5/8"	245'	0
				7"	3738'	2809

Describe in detail the manner in which the well was plugged, indicating where the mud fluid was placed and the method or methods used in introducing it into the hole. If cement or other plugs were used, state the character of same and depth placed, from feet to feet for each plug set.

Plug back depth 3714'

Mud 3714 to 3663

Rock 3663 to 3645

6 sx cement 3645 to 3618

Mud 3618 to 245

Rock bridge 245 to 235

15 sx cement 235 to 222

Mud 222 to 25

Rock bridge 25 to 15

5 sx cement 15 to 10

RECEIVED
STATE CORPORATION COMMISSION

SEP 7 X 1951 9-7-51

(If additional description is necessary, use BACK of this sheet)

S. K. Myers CONSERVATION DIVISION
Wichita, Kansas

Correspondence regarding this well should be addressed to
Address Box 17, Great Bend, Kansas

STATE OF Kansas, COUNTY OF Barton, ss.

Stanton K. Myers (employee or owner) or (owner or operator) of the above-described well,

being first duly sworn on oath, says: That I have knowledge of the facts, statements, and matters herein contained and the log of the above-described well as filed and that the same are true and correct. So help me God

(Signature) Stanton K. Myers

Box 17, Great Bend, Kansas

(Address)

SUBSCRIBED AND SWORN to before me this 6th day of September, 19 51

Zita B. Love

Notary Public.

My commission expires 7-29-55

22-5133-s 9-48-10M

PLUGGING
FILE SEC 14 T 23 R 8
BOOK PAGE 107 LINE 35

THE ATLANTIC REFINING COMPANY
 830 Kennedy Building
 Tulsa 3, Oklahoma

WELL RECORD
CLYDE G. SHORT NO. 1

Center NE-NE-NE of 14-23S-8W, Reno County, Kansas.

North Abbeyville Area

Elevation: 1635 D.F.
 1638 R.K.B.
 1632 G.E.

KS-12,387

Casing Record:
 Set 236.41' of 9-5/8" OD 32# H-40 casing at 245.41 R.K.B. w/250 sax regular cement and 200# calcium chloride.
 Set 3738.45' of 7" OD 23# J-55 casing at 3746.75' w/150 sax Star sulfate and 1/4 of 1% Flocele and 1/4 of 1% Jel.

Dry Hole - To Plug.

FORMATION RECORD

<u>Formation</u>	<u>Top</u>	<u>Bottom</u>
Surface clay	0	30
Shale, sand	30	230
Shale & shells	230	245
Shale, shells & red beds	245	565
Shale & shells	565	780
Shale, shells & salt	780	1056
Shale, shells, sand streaks	1056	1170
Lime shells, shale	1170	1220
Lime	1220	1468
Lime & shale, broken	1468	1535
Lime, hard	1535	1570
Shale	1570	1625
Lime & shale	1625	2050
Shale & shells	2050	2122
Shale, shells, brkn. lime	2122	2258
Lime & shale	2258	2485
Shale & broken lime	2485	2490
Lime, broken	2490	2606
Lime	2606	2787
Shale, lime, broken	2787	2816
Lime & shale	2816	2895
Lime	2895	2939
Shale & lime	2939	3045
Lime & shale	3045	3112
Lime	3112	3187
Lime & shale	3187	3231
Lime	3231	3295
Shale & lime	3295	3303
Lime	3303	3372
Lime, shale	3372	3395
Lime	3395	3422
Lime & shale	3422	3585
Lime	3585	3610
Lime & shale	3610	3613
Lime	3613	3633
Lime, shale	3633	3638
Shale, lime	3638	3655
Lime	3655	3716
Lime, chert & shale	3716	3747
Shale & lime	3747	3843
Lime	3843	3846
Shale	3846	3961
Sandy lime	3961	3963
Lime	3963	4000
Sand	4000	4010
Shale	4010	4055
Lime, shale	4055	4065
Lime	4065	4095

RECEIVED
 STATE CORPORATION COMMISSION
 AUG 20 1951
 CONSERVATION DIVISION
 Wichita, Kansas
 8-20-51

PLUGGING
 FILE SEC 14-23-R-8W
 BOOK PAGE 102 LINE 35

TOTAL DEPTH