

15-155-19093 0000

STATE OF KANSAS
STATE CORPORATION COMMISSION

Form CP-4

WELL PLUGGING RECORD

Give All Information Completely
Make Required Affidavit
Mail or Deliver Report to:
Conservation Division
State Corporation Commission
211 No. Broadway
Wichita, Kansas

Reno County, Sec. 12 Twp. 26 Rge. 9W (E) (W)

Location as "NE/CNW/SW" or footage from lines C W/2 N/W

Lease Owner Messman & Rinehart

Lease Name Neunemaker Well No. I

Office Address 1432 Wichita Plaza, Wichita, Kansas

Character of Well (completed as Oil, Gas or Dry Hole) Gas ~~###~~

Date well completed _____ 19__

Application for plugging filed Nov 19 65

Application for plugging approved Nov 19 65


Plugging commenced Nov 23 19 65

Plugging completed Nov 27 19 65

Reason for abandonment of well or producing formation Dry

If a producing well is abandoned, date of last production _____ 19__

Was permission obtained from the Conservation Division or its agents before plugging was commenced? Yes

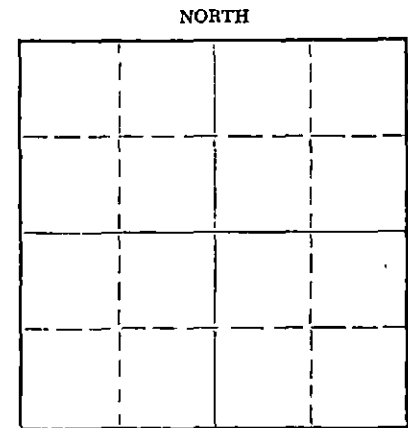

Locate well correctly on above Section Plat

Name of Conservation Agent who supervised plugging of this well Gilbert Toman

Producing formation _____ Depth to top _____ Bottom _____ Total Depth of Well 3970' Feet

Show depth and thickness of all water, oil and gas formations.

OIL, GAS OR WATER RECORDS

CASING RECORD

FORMATION	CONTENT	FROM	TO	SIZE	PUT IN	PULLED OUT
				4 1/2"		2,116'

Describe in detail the manner in which the well was plugged, indicating where the mud fluid was placed and the method or methods used in introducing it into the hole. If cement or other plugs were used, state the character of same and depth placed, from _____ feet to _____ feet for each plug set.

~~#####~~
Pushed plug to 3200'. Made 10' of sand bridge. Dumped 3 sx of cement. Mudded to 230'. Made 10' of rock bridge. Dumped 25 sx of cement. Mudded hole to 35'. Made 5' of rock bridge. Dumped 10 sx of cement, filling to the bottom of the cellar.

RECEIVED
STATE CORPORATION COMMISSION

NOV 30 1965 11-30-65

CONSERVATION DIVISION
WICHITA, KANSAS

(If additional description is necessary, use BACK of this sheet)

Name of Plugging Contractor Art Lamb Casing Pulling Co.

Address 2809 King St. Hutchinson, Kansas

STATE OF Kansas, COUNTY OF Reno, ss.

Art Lamb (employee of owner) or (owner or operator) of the above-described well, being first duly sworn on oath, says: That I have knowledge of the facts, statements, and matters herein contained and the log of the above-described well as filed and that the same are true and correct. So help me God.

(Signature) Art Lamb

2809 King St. Hutchinson, Kansas
(Address)

SUBSCRIBED AND SWORN TO before me this 27 th day of November, 19 65

My commission expires January 5, 1966

Judy Lamb
Notary Public.

NO. 1 NUNEMAKER "F"

15-155-19093-0000

Well Record

Location: Ctr. W/2 NW/4, Sec. 12-26S-9W
Reno County, Kansas

Operator: Messman-Rinehart Oil Company
518 Petroleum Building,
Wichita, Kansas

Contractor: Messman-Rinehart Oil Company
518 Petroleum Building
Wichita, Kansas

Casing Record: 8-5/8" @ 232' w/165 sx. cem.
4-1/2" @ 3970' w/115 sx. cem.

Commenced: February 11, 1958

Completed: February 21, 1958
(rotary)

Elevation: 1662' K/B

Production: Gas

*** LOG ***

Sand and Clay	40
Shale	135
Shale & Red Bed	232
Shale	535
Shale & Red Bed	1000
Shale	1240
Anhydrite	1275
Shale & Shells	1375
Lime & Shale	1565
Lime	1890
Lime & Shale	2940
Lime	3118
Lime, Shale & Sand	3270
Lime & Shale	3360
Lime	3477
Lime	3688
Lime & Shale	3843
Shale & Chert	3875
Chert	3915
Lime & Chert	3932
Lime & Shale	3970 R.T.D.

RECEIVED
STATE CORPORATION COMMISSION

DEC -1 1965 12-1-65

CONSERVATION DIVISION
Wichita, Kansas

Sample Top:

3869' (-2206) Mississippi Chat
3917' (-2254) Mississippi Lime
3935' (-2272) Kinderhook

Log Tops:

3296' (-1633) Brown Lime
3331' (-1668) Lansing

The undersigned, MESSMAN-RINEHART OIL COMPANY, hereby certifies that the above log is a true and correct log of the formation encountered in drilling the above well as reflected by the Daily Drilling Report.

MESSMAN-RINEHART OIL COMPANY

By: J. A. Gilliland
J. A. Gilliland

Subscribed and sworn to before me
this 6th day of March, 1958.

Barbara J. Scott
Barbara J. Scott, Notary Public

My Commission Expires: December 1, 1960

COMPLETION DATA

15-155-19093-0500

Messman-Rinehart Oil Company
No. 1 Nunemaker "F"
Ctr. W/2 NW/4, Section 12-26S-9W
Reno County, Kansas

- 3/25/58 - M.I.C.T.
Ran Lane-Wells Log to 3934 ft.
- 3/26/58 - Plug back to 3934 ft.
Perf. 3873-3878 ft. w/4^s per ft.
Treated with 300 gal. mud acid - tested approx. 1,000 Mcf
- 3/27/58 - Frac. w/4000 gal. geo-frac - Total load 241 bbls.
Swabbed 50 bbls. and well began to flow
Blowing well - gauged 1,800 Mcf (estimated) with water
decreasing to .6 bbl. per hour - completed for approx. 2,000 Mcf
- 4/11/58 - State open flow potential - 2,320 Mcf/day

MESSMAN-RINEHART OIL COMPANY

By:

Roger L. Messman
Roger L. Messman, Partner

RECEIVED
STATE CORPORATION COMMISSION
DEC -1 1965 12-1-65
CONSERVATION DIVISION
Wichita, Kansas

5

SUPPLEMENTARY COMPLETION DATA

Messman-Rinehart Oil Company
No. 1 Nunemaker "F"-Pafford Unit (OWO #1 Nunemaker "F")
W/2 NW/4, Section 12-26S-9W
Reno County, Kansas

- 9/8/65 - Moved in cable tools, killed well and pulled 1" tubing,
Perforated 3204-05' w/4^s ft. (Top of Douglas Sand)
Ran 2" tubing, pressured up to 750#, broke to 500# and circulated,
- 9/9/65 - Squeezed with 100 sx. cement, Pressured to 2,000#, left 82 ft.
of cement in pipe
Waiting on cement
- 9/11/65 - Drilled out cement, Perf. 3204-08' w/4^s ft., treated w/300 gal. MCA,
maximum pressure 600#, eventually broke to 300# and fed in, on
vacuum 15 minutes after flush, very small amount of gas showing
after swabbing back load, then:
 Swabbed 11 bbls. wtr. - 1st hr.
 11 bbls. wtr. - 2nd hr.
 17 bbls. wtr. - 3rd hr.

will pull tubing and shut well down temporarily.

MESSMAN-RINEHART OIL COMPANY

By: 
Roger L. Messman

RLM/bjs
10/4/65