


15-047 20805-0000

STATE OF KANSAS  
STATE CORPORATION COMMISSION

WELL PLUGGING RECORD

Give All Information Completely  
Make Required Affidavit  
Mail or Deliver Report to  
Conservation Division  
State Corporation Comm.  
245 North Water  
Wichita, KS 67202

Edwards County, Sec. 6 Twp. 26S Rge. 16W E/W  
Location as "NE/CNW 1/4 SW 1/4" or footage from lines  
440' FSL; 330' FEL, SW/4  
Lease Owner F. G. Holl  
Lease Name Mathes #1-6 Well No. 1-6  
Office Address 6427 East Kellogg, Wichita, Kansas 67207  
Character of Well (Completed as Oil, Gas or Dry Hole)  
Dry Hole

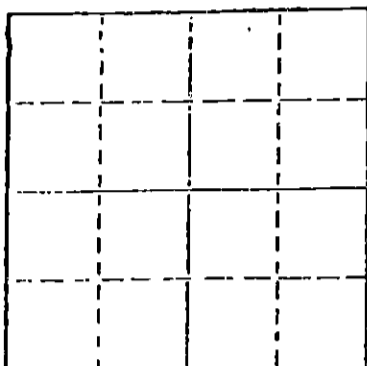

Locate well correctly on above Section Plot

Date Well completed February 19, 1981  
Application for plugging filed February 18, 1981  
Application for plugging approved February 18, 1981  
Plugging commenced 11:45 PM February 18, 1981  
Plugging completed 1:20 AM February 19, 1981  
Reason for abandonment of well or producing formation  
Dry Hole

If a producing well is abandoned, date of last production  
19

Was permission obtained from the Conservation Division or its agents before plugging was commenced? Yes

Name of Conservation Agent who supervised plugging of this well Mr. Leslie  
Producing formation Depth to top Bottom Total Depth of Well 4635'  
Show depth and thickness of all water, oil and gas formations.

OIL, GAS OR WATER RECORDS

CASING RECORD

FORMATION	CONTENT	FROM	TO	SIZE	PUT IN	PULLED OUT
				8 5/8"	409'	None

Describe in detail the manner in which the well was plugged, indicating where the mud fluid was placed and the method or methods used in introducing it into the hold. If cement or other plugs were used, state the character of same and depth placed, from feet to feet for each plug set.

Filled hole with heavy mud.  
Heavy mud to 600' with 40 sacks 50/50 Pozmix #1 through open ended drill pipe at 600'; heavy mud to 409' with 40 sacks through open ended drill pipe; heavy mud to 40', Howco plug and 1/2 sacks hulls and solid bridge at 40' with 10 sacks to surface and 15 sacks in rathole.

(If additional description is necessary, use BACK of this sheet)

Name of Plugging Contractor Sterling Drilling Company, P. O. Box 129, Sterling, Kansas 67579

STATE OF KANSAS COUNTY OF RICE, ss.  
Bernard Laudermilk (employee of owner) or (owner or operator)  
of the above-described well, being first duly sworn on oath, says: That I have knowledge of the facts, statements, and matters herein contained and the log of the above-described well as filed and that the same are true and correct. So help me God.

(Signature) Bernard Laudermilk  
Bernard Laudermilk, President  
P. O. Box 129, Sterling, Kansas 67579 (Address)

SUBSCRIBED AND SWORN TO before me this 21st day of February, 1981.



RECEIVED Charles M. Hall  
Charles M. Hall, Notary Public.

My commission expires

FEB 24 1981  
2-24-1981  
CONSERVATION DIVISION  
Wichita, Kansas

STERLING DRILLING COMPANY  
P. O. Box 129  
Sterling, Kansas 67579

15-047-20205-0000

WELL LOG - - - - - MATHES #1-6  
Located: 440' FSL; 330' FEL; SW/4, Section 6-26S-16W,  
Edwards County, Kansas

OWNER: F. G. Holl  
ROTARY DRILLING CONTRACTOR: Sterling Drilling Company

COMMENCED: February 12, 1981  
COMPLETED: February 19, 1981

TOTAL DEPTH: 4635'

<u>LOG</u>	<u>CASING RECORD</u>
0 - 438 Sand, Clay and Shale	Ran 10 joints used 8 5/8", 24# used casing. 398' pipe set at 409' K.B. Cemented with 400 sacks 60/40 Pozmix with 2% gel and 3% cc. Plug down at 6:00 PM, 2-12-81, by Howco.
438 - 1118 Shale	
1118 - 1135 Anhydrite	
1135 - 1790 Shale	
1790 - 3965 Lime and Shale	
3965 - 4155 Lime	
4155 - 4635 Lime and Shale	Plugged.

Deviation Surveys: 1/2° at 2155'  
3° at 4635'

STATE

FEB 24 1981

CO. KANSAS