


15-897-10078.0000

WELL PLUGGING RECORD

Give All Information Completely
Make Required Affidavit
Mail or Deliver Report to:
Conservation Division
State Corporation Commission
212 North Market, Insurance Bldg.
Wichita, Kansas

Edwards County. Sec. 9 Twp. 26S Rge. 16W (E) (W)
Location as "NE/CNW/SW" or footage from lines: NE SW NW
Lease Owner: National Cooperative Refinery Assn.
Lease Name: Parker Well No. 1
Office Address: 3rd Floor, Rule Bldg., Wichita, Kansas
Character of Well (completed as Oil, Gas or Dry Hole): Dry Hole
Date well completed: 10-17-59
Application for plugging filed: 10-16-59
Application for plugging approved: 10-16-59
Plugging commenced: 10-16-59
Plugging completed: 10-17-59
Reason for abandonment of well or producing formation: Dry Hole

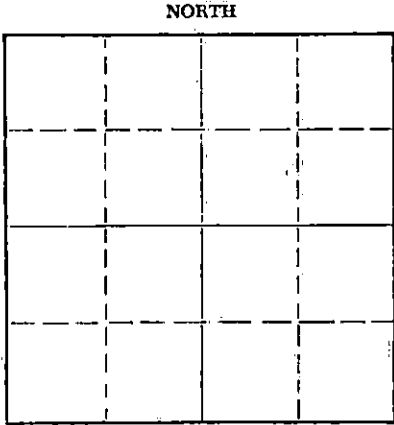

Locate well correctly on above Section Plat

If a producing well is abandoned, date of last production: 19
Was permission obtained from the Conservation Division or its agents before plugging was commenced? Yes

Name of Conservation Agent who supervised plugging of this well: Frank Broadfoot
Producing formation: Depth to top: Bottom: Total Depth of Well: 4500 Feet
Show depth and thickness of all water, oil and gas formations.

OIL, GAS OR WATER RECORDS

CASING RECORD

FORMATION	CONTENT	FROM	TO	SIZE	PUT IN	PULLED OUT
				8 5/8	432	

Describe in detail the manner in which the well was plugged, indicating where the mud fluid was placed and the method or methods used in introducing it into the hole. If cement or other plugs were used, state the character of same and depth placed, from feet to feet for each plug set.

1st plug @ 300' w/ 20 sx. cmt. & 1/4 sk. hulls
Top plug @ 35' w/ 10 sx. cmt. & 1/4 sk. hulls.

RECEIVED
STATE CORPORATION COMMISSION
OCT 26 1959
CONSERVATION DIVISION
Wichita, Kansas

(If additional description is necessary, use BACK of this sheet)
Name of Plugging Contractor: Leben Drilling, Inc.
Address: 905 Central Bldg., Wichita, Kansas

STATE OF KANSAS, COUNTY OF SEDGWICK, ss. Frank Hamlin (employee of owner) or (owner or operator) of the above-described well, being first duly sworn on oath, says: That I have knowledge of the facts, statements, and matters herein contained and the log of the above-described well as filed and that the same are true and correct. So help me God.

(Signature) Frank Hamlin
905 Central Bldg., Wichita, Kansas (Address)

SUBSCRIBED AND SWORN TO before me this 22nd day of October, 19 59

My commission expires April 23, 1963
Juanita M. Green Notary Public

DRILLER'S LOG

COMPANY:
CONTRACTOR:
FARM:
LOCATION:
COMMENCED:
COMPLETED:

NATIONAL COOPERATIVE REFINERY ASSOCIATION
LEBEN DRILLING, INC.
PARKER #1
NE SW NW SEC. 9-26S-16W
EDWARDS COUNTY, KANSAS
10-2-59
10-17-59

15-097-10578-0000

0	90	Sand
90	260	Sand and Shale
260	432	Shale and Shells
432	925	Shale and Shells
925	1067	Shale and Redbed
1067	1095	Anhydrite
1095	1460	Shale and Shells
1460	1960	Shale and Lime
1960	2175	Lime and Shale
2175	2260	Lime
2260	2410	Lime
2410	2485	Lime
2485	2655	Lime and Shale
2655	2830	Lime and Shale
2830	2974	Lime and Shale
2974	3055	Lime and Shale
3055	3375	Lime and Shale
3375	3670	Lime and Shale
3670	3722	Lime
3722	3845	Shale and Lime
3845	3950	Lime
3950	4130	Lime
4130	4310	Lime
4310	4370	Lime and Shale
4370	4385	Lime
4385	4415	Shale and Sand
4415	4428	Lime and Chert
4428	4464	Shale and Sand
4464	4485	Kinderhook Sand
4485	4493	Viola
4493	4500	Viola Lime
	4500	<u>Rotary Total Depth - D & A</u>

VED
COMMISSION
OCT 26 1959
CONSERVATION DIVISION
Wichita, Kansas

Set 8 5/8" surface casing @ 432' with 285 sacks 6 hour cement.

I, Frank Hamlin do hereby certify that the above and foregoing is a true and correct copy of the log of the Parker #1, located NE SW NW of Section 9, Township 26 South, Range 16 West, Edwards County, Kansas, as reflected by the files of Leben Drilling, Inc.

Frank Hamlin
Frank Hamlin

STATE OF KANSAS)
COUNTY OF SEDGWICK) SS.

Subscribed and sworn to before me, a Notary Public, in and for Sedgwick County, Kansas, this 22nd day of October, 1959.

Juanita M. Green
Juanita M. Green, Notary Public

My Commission Expires:
April 23, 1963