


15-047-00043-0000

STATE OF KANSAS
STATE CORPORATION COMMISSION
Give All Information Completely
Make Required Affidavit
Mail or Deliver Report to:
Conservation Division
State Corporation Commission
211 No. Broadway
Wichita, Kansas

WELL PLUGGING RECORD

Edwards County, Sec. 10 Twp. 26 Rge. 16 (W) (W)
Location as "NE/CNW/SW" or footage from lines NE NE SE
Lease Owner Ambassador Oil Corporation
Lease Name Hill Well No. 1
Office Address 304 High Tower Bldg., Oklahoma City, Okla.
Character of Well (completed as Oil, Gas or Dry Hole) Dry hole
Date well completed 5-8- 1956
Application for plugging filed 5-8- 1956
Application for plugging approved 5-8- 1956
Plugging commenced 5-8- 1956
Plugging completed 5-8- 1956
Reason for abandonment of well or producing formation dry hole

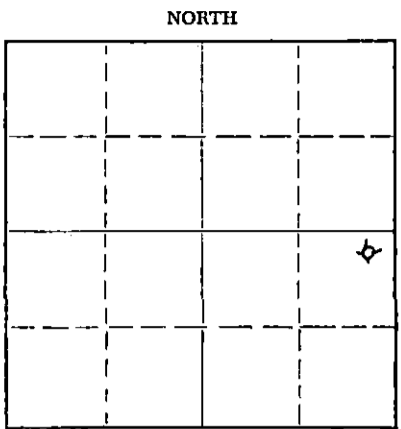

Locate well correctly on above Section Plat

If a producing well is abandoned, date of last production _____ 19____
Was permission obtained from the Conservation Division or its agents before plugging was commenced? yes

Name of Conservation Agent who supervised plugging of this well M. A. Rives
Producing formation _____ Depth to top _____ Bottom _____ Total Depth of Well 4755 Feet
Show depth and thickness of all water, oil and gas formations.

OIL, GAS OR WATER RECORDS

CASING RECORD

FORMATION	CONTENT	FROM	TO	SIZE	PUT IN	PULLED OUT
	<u>Ran 8-5/8" (new) (259.54) set @ 267 w/302 sacks</u>					

Describe in detail the manner in which the well was plugged, indicating where the mud fluid was placed and the method or methods used in introducing it into the hole. If cement or other plugs were used, state the character of same and depth placed, from _____ feet to _____ feet for each plug set.

Plugged hole - filled hole with heavy mud. Mixed 85 sacks cement and pumped down with same.
P.D. 8:00 p.m. 5-8-56

(If additional description is necessary, use BACK of this sheet)

Name of Plugging Contractor Garvey Drilling Co.
Address 311 East Third, Wichita, Kansas

STATE OF OKLAHOMA COUNTY OF OKLAHOMA, ss.
AMBASSADOR OIL CORPORATION (employee of owner) or (owner or operator) of the above-described well, being first duly sworn on oath, says: That I have knowledge of the facts, statements, and matters herein contained and the log of the above-described well as filed and that the same are true and correct. So help me God.

(Signature) James A. Water...
(Address) _____

SUBSCRIBED AND SWORN to before me this 21st day of May, 1956
My commission expires Nov. 28, 1957
Margaret O'Neil
MAY 22 1956 Notary Public.

PLUGGING
FILE SEC. 10 T. 26 R. 16W
BOOK PAGE 60 LINE 18

CONSERVATION DIVISION
Wichita, Kansas
5-22-1956

WELL LOG

15-047-00043-0000

COMPANY AMBASSADOR OIL CORPORATION

SEC. 10 T. 26S R. 16W

FARM Hill NO. 1


LOC. NE NE SE

TOTAL DEPTH 4755'

COUNTY Edwards Co., Kansas

COMM. April 22, 1956 COMP. May 8, 1956

CONTRACTOR GARVEY DRILLING COMPANY

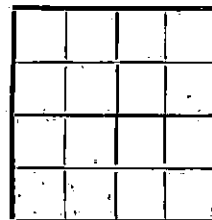

CASING 8-5/8" @ 267' w/302 sacks

ELEVATION 2059 D.F.

PRODUCTION Dry

FIGURES INDICATE BOTTOM OF FORMATIONS

310	Shale & Sand
355	Sand
550	Red Bed
1053	Red Bed & Shale
1320	Lime & Shale
1730	Shale & Shells
2180	Lime & Shale
2540	Lime
2665	Lime & Shale
2870	Shale & Shells
3415	Shale & Lime
3535	Shale & Sandy Lime
3670	Shale & Shells
3870	Shale & Lime
4245	Lime
4293	Lime & Shale
4358	Lime
4410	Conglomerate
4462	Shale
4510	Chert
4542	Chert & Lime
4574	Chert
4610	Lime
4660	Lime & Sand
4690	Shale & Lime
4755	Lime
4755	T.D.

PLUGGING
 FILE SEC 10 T 26 R 16W
 BOOK PAGE 60 LINE 18

State of KANSAS }
County of SEDGWICK } ss:

I, Carl Hurty of GARVEY DRILLING COMPANY

upon oath state that the above is a true and correct copy of the log of the #1 Hill well

RECEIVED
 MAY 22 1956
 CONSERVATION DIVISION
 Wichita, Kansas

Carl Hurty

Subscribed and sworn to before me this 17th day of May 19 56

My Commission Expires: July 8, 1958

D. M. Kennedy
NOTARY PUBLIC