

AFFIDAVIT AND COMPLETION FORM

ACO-1

This form must be filed in triplicate with the Kansas Corporation Commission, 200 Colorado Derby Building, Wichita, Kansas 67202, within five days after the completion of the well, regardless of how the well was completed. Circle one: Oil, gas, dry, SWD, OWWO, injection. Please type. Complete ALL sections. Applications must be filed for dual completion, commingling, salt water disposal and injection. Attach wireline logs (i.e. electrical, log, sonic log, gamma ray neutron log, etc.) KCC#-(316) 263-3238.


OPERATOR Patton Oil Company API NO. 15 - 047 - 20,999-0000
 ADDRESS 5660 South Syracuse Circle - #200 COUNTY Edwards
Englewood, Colorado 80110 FIELD S.W. WTL / WIL
 **CONTACT PERSON Harold Patton, Jr. LEASE Southwestern College
 PHONE 303-773-6016

PURCHASER PERMIAN WELL NO. #10
 ADDRESS _____ WELL LOCATION NW/4
 _____ 1650' Ft. from NSL Line and
 _____ 1650' Ft. from FWL Line of
 DRILLING CONTRACTOR Big Springs Drilling, Inc. the SEC. 3 TWP. 26S RGE. 16W

ADDRESS P. O. Box 8287 - Munger Station
Wichita, Kansas 67208

PLUGGING CONTRACTOR N/A
 ADDRESS _____

TOTAL DEPTH 4420' PBTD _____
 SPUD DATE 1-29-82 DATE COMPLETED 2-4-82
 ELEV: GR2097' DF KB 2084

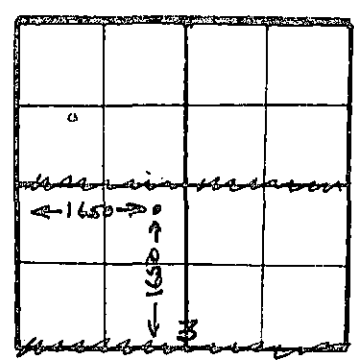

WELL PLAT
Quarter
 or (Full)
 Section -
 Please
 indicate.
 KCC ✓
 KGS ✓

DRILLED WITH (CABLE) (ROTARY) (AIR) TOOLS
 Report of all strings set— surface, intermediate, production, etc. (New) / (Used) casing.

Purpose of string	Size hole drilled	Size casing set (in O.D.)	Weight lbs/ft.	Setting depth	Type cement	Sacks	Type and percent additives
Surface	12 1/4"	8 5/8"	20#	480'	Common	325 SX	2% gel 3% ccl
PRODUCTION		5 1/2"		4417	COMMON	175	10% SALT

LINER RECORD			PERFORATION RECORD		
Top, ft.	Bottom, ft.	Sacks cement	Shots per ft.	Size & type	Depth interval
TUBING RECORD					
Size	Setting depth	Packer set at			
5 1/2"	4417'	4431			

RECEIVED

ACID, FRACTURE, SHOT, CEMENT SQUEEZE RECORD STATE COMMISSION
 Amount and kind of material used
ACIDIZED WITH 500 GALS. OF REG. 15% ACID, 10% ALCOHOL
15,000# OF 20/40 SAND AND 5,000# 10/20 SAND MIX

APR 14 1982
 CONSERVATION DIVISION
 Wichita, Kansas
 4-14-1982

TEST DATE: _____ PRODUCTION
 Date of first production 3-24-82 Producing method (flowing, pumping, gas lift, etc.) A.P.I. Gravity _____
 RATE OF PRODUCTION PER 24 HOURS
 Oil 25 bbls. Gas _____ MCF Water 0 % Gas-oil ratio _____ CFPB
 Disposition of gas (vented, used on lease or sold) _____ Producing interval (s) _____

** The person who can be reached by phone regarding any questions concerning this information.
 A witnessed initial test by the Commission is required if the well produces more than 25 BOPD or is located in a Basic Order Pool.

Name of lowest fresh water producing stratum Sand Depth 135'
 Estimated height of cement behind pipe Circulated

WELL LOG

SHOW GEOLOGICAL MARKERS, LOGS RUN, OR OTHER DESCRIPTIVE INFORMATION.

Show all important zones of porosity and contents thereof; cored intervals, and all drill-stem tests, including depth interval tested, cushion used, time tool open, flowing and shut-in pressures, and recoveries.

FORMATION DESCRIPTION, CONTENTS, ETC.	TOP	BOTTOM	NAME	DEPTH
<u>Drillers Log</u>				
Sand	0	225'		
Shale & Sand	225'	1360'		
Shale	1360'	2187'		
Shale & Lime	2187'	4420'		
RTD	4420'			
FORMATION TOPS				
HEEBNER	3753	1669		
DOUGLAS	3791	1707		
BROWN LIME	3899	1815		
LANSING	3919	1835		
BASE KANSAS CITY	4178	2094		
PAWNEE	4332	2248		
FORT SCOTT	4362	2278		
CHEROKEE SNAD	4375	2291		
SHALY CONGLOMERATE	4385	2301		
KINDERHOOK SAND	4414	2330		
T.D.	4420	2336		

USE ADDITIONAL SHEETS, IF NECESSARY, TO COMPLETE WELL RECORD.

A F F I D A V I T

STATE OF COLORADO, COUNTY OF ARAPAHOE SS,

HAROLD W. PATTON, JR. OF LAWFUL AGE, BEING FIRST DULY SWORN UPON HIS OATH, DEPOSES AND SAYS:

THAT HE IS PRESIDENT ~~FOR~~ FOR OF PATTON OIL CO. OPERATOR OF THE SOUTHWESTERN COLLEGE LEASE, AND IS DULY AUTHORIZED TO MAKE THIS AFFIDAVIT FOR AND ON BEHALF OF SAID OPERATOR, THAT WELL NO. #10 ON SAID LEASE HAS BEEN COMPLETED AS OF THE March DAY OF 3rd 19 82, AND THAT ALL INFORMATION ENTERED HEREIN WITH RESPECT TO SAID WELL IS TRUE AND CORRECT.

FURTHER AFFIANT SAITH NOT.

PATTON OIL CO

(Signature)
 HAROLD W. PATTON, JR., PRESIDENT

SUBSCRIBED AND SWORN TO BEFORE ME THIS 12th DAY OF APRIL 19 82

(Signature)
 NOTARY PUBLIC

MY COMMISSION EXPIRES: OCTOBER 14, 1984

ELAINE MUNDORF
 5660 S. SYRACUSE CIRCLE
 SUITE #200
 ENGLEWOOD, COLORADO 80110