

TYPE

AFFIDAVIT OF COMPLETION FORM

ACO-1 WELL HISTORY

Compt. _____

SIDE ONE

Two (2) copies of this form shall be filed with the Kansas Corporation Commission, 200 Colorado Derby Building, Wichita, Kansas 67202, within thirty (30) days after the completion of a well, regardless of how the well was completed.


F Attach separate letter of request if the information is to be held confidential. If confidential, only file one copy. Information on Side One will be of public record and Side Two will then be held confidential.

Applications must be made on dual completion, commingling, salt water disposal, injection and temporarily abandoned wells.

C Attach one copy only wireline logs (i.e. electrical log, sonic log, gamma ray neutron log, etc.). (Rules 82-2-105 & 82-2-125) KCC# (316) 263-3238.

LICENSE # 6139 EXPIRATION DATE 6-30-83
 OPERATOR Jay C. Boyer API NO. 15-155-20,705-0000
 ADDRESS P. O. Box 511 COUNTY Reno
Hays, Kansas 67601 FIELD Smoots Creek
 ** CONTACT PERSON Jay C. Boyer PROD. FORMATION KC
 PHONE 913-625-6967
 PURCHASER NCRA LEASE McCullough
 ADDRESS Box 1167 WELL NO. 2
McPherson, Kansas 67460 WELL LOCATION C E/2 E/2 SW
 DRILLING Brandt Drilling Co., Inc. 1320 Ft. from North Line and
 CONTRACTOR ADDRESS 1200 Douglas Bldg. 330 Ft. from East Line of
Wichita, Kansas 67202 the SW (Qtr.) SEC 36 TWP 26 RGE 8

PLUGGING CONTRACTOR ADDRESS _____

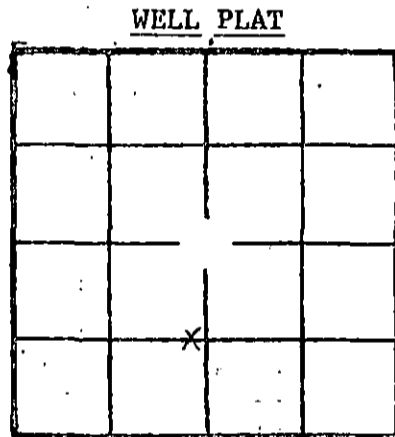

(Office Use Only)
 KCC
 KGS
 SWD/REP _____
 PLG. _____

TOTAL DEPTH 3700 PBTD 3690
 SPUD DATE 10-9-80 DATE COMPLETED 10-18-80
 ELEV: GR 1587 DF 1589 KB 1592
 DRILLED WITH (CABLE) (ROTARY) (AIR) TOOLS.
 DOCKET NO. OF DISPOSAL OR REPRESSURING WELL BEING USED TO DISPOSE OF WATER FROM THIS LEASE _____

Amount of surface pipe set and cemented 199 DV Tool Used? no

THIS AFFIDAVIT APPLIES TO: (Circle ONE) Oil, Gas, Shut-in Gas, Dry, Disposal, Injection, Temporarily Abandoned, OWWO, Other _____

ALL REQUIREMENTS OF THE STATUTES, RULES AND REGULATIONS PROMULGATED TO REGULATE THE OIL AND GAS INDUSTRY HAVE BEEN FULLY COMPLIED WITH.

A F F I D A V I T

Jay C. Boyer, being of lawful age, hereby certifies that:

I am the Affiant, and I am familiar with the contents of the foregoing Affidavit. The statements and allegations contained therein are true and correct.

Jay C. Boyer
 (Name)

SUBSCRIBED AND SWORN TO BEFORE ME this 13th day of October, 1982.

ARILLA A. MIZELL
 Ellis County, Kansas
 My Appt. Exp. Nov. 25, 1982

Arilla A. Mizell
 (NOTARY PUBLIC)

MY COMMISSION EXPIRES: _____

OCT 15 1982
 CONSERVATION DIVISION
 Wichita, Kansas
 10-15-82

** The person who can be reached by phone regarding any questions concerning this information.

