

SIDE ONE

Two (2) copies of this form shall be filed with the Kansas Corporation Commission, 200 Colorado Derby Building, Wichita, Kansas 67202, within thirty (30) days after the completion of a well, regardless of how the well was completed.

F Attach separate letter of request if the information is to be held confidential. If confidential, only file one copy. Information on Side One will be of public record and Side Two will then be held confidential.

Applications must be made on dual completion, commingling, salt water disposal, injection and temporarily abandoned wells.

C Attach one copy only wireline logs (i.e. electrical log, sonic log, gamma ray neutron log, etc.). (Rules 82-2-105 & 82-2-125) KCC# (316) 263-3238.

LICENSE # 6139 EXPIRATION DATE 6-30-83

OPERATOR Jay C. Boyer API NO. 15-155-20,785-0000

ADDRESS P. O. Box 511 COUNTY Reno

Hays, Kansas 67601 FIELD Smoots Creek

** CONTACT PERSON Jay C. Boyer PROD. FORMATION KC

PHONE 913-625-6967

PURCHASER NCRA LEASE McCullough

ADDRESS Box 1167 WELL NO. 4


McPherson, Kansas 67460 WELL LOCATION 45' N of C S/2 SW

DRILLING Brandt Drilling Co., Inc. 705Ft. from South Line and

CONTRACTOR 1200 Douglas Bldg. 1320Ft. from East Line of

ADDRESS Wichita, Kansas 67202 the SW (Qtr.) SEC 36 TWP 26 RGE 8

PLUGGING CONTRACTOR ADDRESS

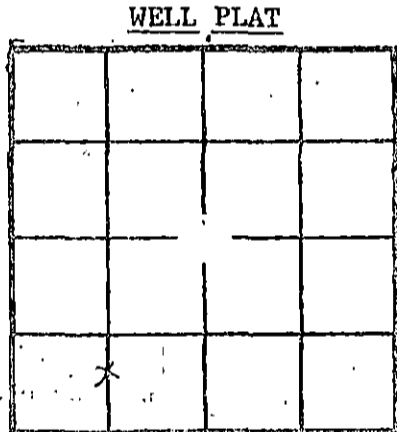

(Office Use Only) KCC [checked] KGS [checked] SWD/REP PLG.

TOTAL DEPTH 3720 PBD 3684

SPUD DATE 6-19-81 DATE COMPLETED 6-20-81

ELEV: GR 1599 DF 1601 KB 1604

DRILLED WITH (CABLE) (ROTARY) (AIR) TOOLS.

DOCKET NO. OF DISPOSAL OR REPRESSURING WELL BEING USED TO DISPOSE OF WATER FROM THIS LEASE

Amount of surface pipe set and cemented 199 DV Tool Used? no

THIS AFFIDAVIT APPLIES TO: (Circle ONE) Oil Gas, Shut-in Gas, Dry, Disposal, Injection, Temporarily Abandoned, OWWO. Other

ALL REQUIREMENTS OF THE STATUTES, RULES AND REGULATIONS PROMULGATED TO REGULATE THE OIL AND GAS INDUSTRY HAVE BEEN FULLY COMPLIED WITH.

A F F I D A V I T

Jay C. Boyer, being of lawful age, hereby certifies that:

I am the Affiant, and I am familiar with the contents of the foregoing Affidavit. The statements and allegations contained therein are true and correct.

Jay C. Boyer (Signature)

SUBSCRIBED AND SWORN TO BEFORE ME this 13th day of October

1982.

ARILLA A. MIZELL, Notary Public, My Appt. Exp. Nov. 28, 1982

MY COMMISSION EXPIRES:

NOTARY PUBLIC RECEIVED OCT 15 1982 CONSERVATION DIVISION WICHITA, KANSAS 10-15-82

** The person who can be reached by phone regarding any questions concerning this information.

OPERATOR

Jay C. Boyer

LEASE

McCullough

SEC. 36 TWP. 26 RGE. 8

FILL IN WELL INFORMATION AS REQUIRED:

WELL NO. 4

Show all important zones of porosity and contents thereof; cased intervals, and all drill-stem tests, including depth interval tested, cushion used, time tool open, flowing and shut-in pressures, and recoveries.

SHOW GEOLOGICAL MARKERS, LOGS RUN, OR OTHER DESCRIPTIVE INFORMATION.

FORMATION DESCRIPTION, CONTENTS, ETC.	TOP	BOTTOM	NAME	DEPTH
<input checked="" type="checkbox"/> Check if no Drill Stem Tests Run.				
Heebner Sh.	3039			
Brown Lime	3255			
Lansing-KC	3271			
Stark Sh.	3588			
Hushpuckney	3637			
Base KC	3704			

If additional space is needed use Page 2, Side 2

Report of all strings set— surface, intermediate, production, etc. CASING RECORD ((New) or (Used))

Purpose of string	Size hole drilled	Size casing set (in O.D.)	Weight lbs/ft.	Setting depth	Type cement	Socks	Type and percent additive
Surface	12 1/2	8 5/8	24	199	Common	130	2% gel 3% cc
Production	7 7/8	4 1/2	9.50	3718	60/40 Poz	150	7 1/2% salt

LINER RECORD

PERFORATION RECORD

Top, ft.	Bottom, ft.	Socks cement	Shots per ft.	Size & type	Depth interval
			8 total		3608-12
TUBING RECORD			8 total		3650-54
Size	Setting depth	Packer set at			
2"	3716				

ACID, FRACTURE, SHOT, CEMENT SQUEEZE RECORD

Amount and kind of material used	Depth interval treated

Date of first production: 8-2-81 Producing method (flowing, pumping, gas lift, etc.): Gravity 35

Estimated -I.P. Oil // Gas Water 78% Gas-oil ratio

Disposition of gas (vented, used on lease or sold) Perforations