


STATE OF KANSAS  
STATE CORPORATION COMMISSION

Give All Information Completely  
Make Required Affidavit  
Mail or Deliver Report to:  
Conservation Division  
State Corporation Commission  
211 No. Broadway  
Wichita, Kansas

WELL PLUGGING RECORD

NORTH

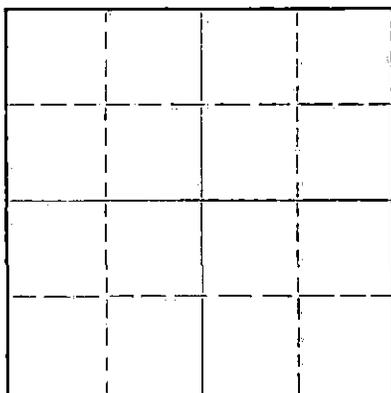

Locate well correctly on above  
Section Plat

Reno County. Sec. 25 Twp. 26 Rge. 8 (E) 8 (W)  
Location as "NE/CNW/SW" or footage from lines SE SE SE  
Lease Owner Aylward Drilling Company  
Lease Name Hay Well No. 1  
Office Address 813 1st Nat'l Bank Bldg., Wichita 2, Kansas  
Character of Well (completed as Oil, Gas or Dry Hole) Dry Hole  
Date well completed June 12 1959  
Application for plugging filed June 12 1959  
Application for plugging approved June 12 1959  
Plugging commenced June 12 1959  
Plugging completed June 12 1959  
Reason for abandonment of well or producing formation

If a producing well is abandoned, date of last production 19  
Was permission obtained from the Conservation Division or its agents before plugging was commenced? Yes

Name of Conservation Agent who supervised plugging of this well  
Producing formation Depth to top Bottom Total Depth of Well Feet  
Show depth and thickness of all water, oil and gas formations.

OIL, GAS OR WATER RECORDS

CASING RECORD

| FORMATION | CONTENT | FROM | TO | SIZE   | PUT IN | PULLED OUT |
|-----------|---------|------|----|--------|--------|------------|
|           |         |      |    | 8 5/8" | 245'   | None       |
|           |         |      |    |        |        |            |
|           |         |      |    |        |        |            |
Describe in detail the manner in which the well was plugged, indicating where the mud fluid was placed and the method or methods used in introducing it into the hole. If cement or other plugs were used, state the character of same and depth placed, from feet to feet for each plug set.

Filled hole with heavy mud from total depth to 240'; set plug with 1/3 sack of hulls and 18 sacks of cement through drill pipe; heavy mud to 35'; set plug with 1/4 sack hulls and 10 sacks of cement through drill pipe; bridge rat hole at 8' with hulls and 2 sacks of cement on top.

8-21-59

RECEIVED  
STATE CORPORATION COMMISSION

AUG 21 1959

CONSERVATION DIVISION  
Wichita, Kansas

(If additional description is necessary, use BACK of this sheet)

Name of Plugging Contractor Aylward Drilling Company  
Address 813 1st National Bank Bldg. - Wichita 2, Kansas

STATE OF Kansas, COUNTY OF Sedgwick, ss.  
Paul W. Hesse (employee of owner) or (owner or operator) of the above-described well, being first duly sworn on oath, says: That I have knowledge of the facts, statements, and matters herein contained and the log of the above-described well as filed and that the same are true and correct. So help me God.

(Signature) Paul W. Hesse  
813 1st Nat'l Bank Bldg., Wichita 2, Kansas (Address)

SUBSCRIBED AND SWORN TO before me this 15th day of June, 1959

My commission expires 12-11-61

Duane Jessup Notary Public.

PLUGGING  
FILE SEC. 25 T. 26 R. 8 W.  
BOOK PAGE 45 LINE 13

HAY NO. 1

Casing Records:  
8 5/8" - 245'

Company: Aylward Drilling Company et al  
Contractor: Aylward Drilling Company  
Commenced: May 29, 1959  
Completed: June 12, 1959

Location: SE SE SE 25-26-8W  
Reno County, Kansas  
Elevation: 1608 R.B.

|                         | <u>From</u> | <u>To</u> | <u>Remarks</u>   |      |
|-------------------------|-------------|-----------|--|------|
| Sand & red bed          | 0           | 55        | Set 8 5/8" surface pipe @ 245' w/225 sax cement.   |      |
| Sand w/red bed          | 55          | 80        |  |      |
| Red bed                 | 80          | 215       | Geological Tops:<br><br>Brown Lime 3270<br>Lansing 3286<br>Miss. 3947<br>Kinderhook 4076<br>Misner 4300<br>Viola 4314<br>Simpson 4340<br>T.D. 4363   |      |
| Shale & red bed         | 215         | 290       |  |      |
| Shale & shells          | 290         | 780       |  |      |
| Salt & shale            | 780         | 1075      |  |      |
| Shale & lime            | 1075        | 1350      |  |      |
| Shale                   | 1350        | 1460      |  |      |
| Lime                    | 1460        | 1532      |  |      |
| Lime & some shale       | 1532        | 1760      |  |      |
| Lime & Shale            | 1760        | 1835      |  |      |
| Shale & lime            | 1835        | 1890      |  |      |
| Lime & shale            | 1890        | 2115      | DST 3945-63 Open 1 hr. St. bl.<br>Rec. 865' SI.GCWM & MSW<br>[BHP 1440#/20" - FBHP 1345#/30"<br>FP 50#-435#<br><br>DST 3550-64 Open 1 hr. Good blow.<br>Rec. 210' gas in DP, 150' O&GCM, 120'<br>Wtry O&GCM, 300' O&GMSW, 60' SW<br>[BHP 1545#/20" - FBHP 1280#/30"<br>FP 70#-290# |      |
| Shale                   | 2115        | 2390      |  |      |
| Shale w/lime            | 2390        | 2540      |  |      |
| Shale & lime            | 2540        | 2790      |  |      |
| Lime & shale            | 2790        | 3325      |  |      |
| Lime                    | 3325        | 3722      |  |      |
| Lime & some shale       | 3722        | 3794      |  |      |
| Lime w/shale            | 3794        | 3850      |  |      |
| Lime & shale            | 3850        | 3938      |  |      |
| Chert & lime            | 3938        | 3960      |  |      |
| Lime                    | 3960        | 3963      | Ran Schlumberger electric log.<br><br>D & A  |      |
| Lime & chert            | 3963        | 4075      |  |      |
| Lime w/some shale       | 4075        | 4122      |  |      |
| Shale w/small amt. lime | 4122        | 4157      |  |      |
| Shale & lime            | 4157        | 4218      |  |      |
| Shale                   | 4218        | 4304      |  |      |
| Shale & sand            | 4304        | 4320      |  |      |
| Shale w/sand            | 4320        | 4363      |  |      |
|                         |             |           |  | T.D. |

8-21-59  
**RECEIVED**  
STATE CORPORATION COMMISSION  
AUG 21 1959  
CONSERVATION DIVISION  
Wichita, Kansas

I hereby certify that this is a true and correct copy of the above log to the best of my knowledge.

Charles D. Williams

Subscribed and sworn to before me this 22nd day of June, 1959.

Paul W. Hester  
Notary Public

My commission expires December 11, 1961

**PLUGGING**  
 FILE SEC. 25 T. & G. R. 8W  
 BOOK PAGE 45 LINE 43