


Give All Information Completely
Make Required Affidavit
Mail or Deliver Report to:
Conservation Division
State Corporation Commission
212 No. Market
Wichita, Kansas

WELL PLUGGING RECORD

NORTH

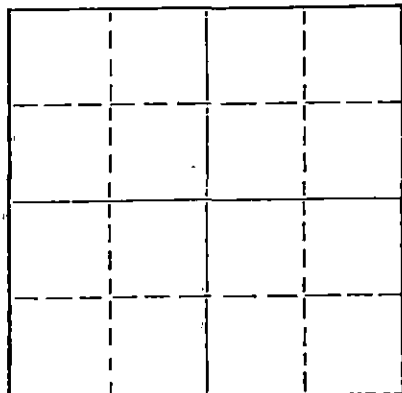

Locate well correctly on above
Section Plat

Reno County. Sec. 19 Twp. 26 Rge. 8 (#) (W)
Location as "NE/CNW/SW" or footage from lines NW-NW
Lease Owner Aspen Drilling Co.
Lease Name Jones Well No. 1
Office Address Box 783 Great Bend, Kansas 67530
Character of Well (completed as Oil, Gas or Dry Hole) gas
Date well completed August 4 19 76
Application for plugging filed October 12 19 76
Application for plugging approved October 18 19 76
Plugging commenced 19
Plugging completed January 17 19 76
Reason for abandonment of well or producing formation dry

If a producing well is abandoned, date of last production 19
Was permission obtained from the Conservation Division or its agents before plugging was commenced? yes

Name of Conservation Agent who supervised plugging of this well Gilbert Toman
Producing formation Winfield Depth to top 1442 Bottom 1504 Total Depth of Well 1529 Feet
Show depth and thickness of all water, oil and gas formations.

OIL, GAS OR WATER RECORDS

CASING RECORD

FORMATION	CONTENT	FROM	TO	SIZE	PUT IN	PULLED OUT
		surface	216	8 5/8	216	-
		"	1529	4 1/2	1529	1098.00

Describe in detail the manner in which the well was plugged, indicating where the mud fluid was placed and the method or methods used in introducing it into the hole. If cement or other plugs were used, state the character of same and depth placed, from feet to feet for each plug set.

Sand plug from 1529' to 1465'
mix & plug w/bailler 5 sx. common cement
Sun cementing Co. mixed & pumped 3 sx. hull's,
20 gel., down 8 5/8" casing followed w/85 sx.
50/50 pozmix 2% gel.

FEB 07 1977 2-7-77

CORRECTION DIVISION
Wichita, Kansas

(If additional description is necessary, use BACK of this sheet)

Name of Plugging Contractor Pawnee Well Service, Inc.
Address Box 783 Great Bend, Kansas 67530

STATE OF Kansas COUNTY OF Barton, ss.
Robert L. Pelster (employee of owner) or (owner or operator) of the above-described well, being first duly sworn on oath, says: That I have knowledge of the facts, statements, and matters herein contained and the log of the above-described well as filed and that the same are true and correct. So help me God.

(Signature) [Signature]
723 McKinley Great Bend, Kansas 67530
(Address)

SUBSCRIBED AND SWORN TO before me this 3rd day of February, 19 77

My Commission expires June 17, 1980

Dorothy King
Dorothy King Notary Public.

