


STATE OF KANSAS  
STATE CORPORATION COMMISSION

Give All Information Completely  
Make Required Affidavit  
Mail or Deliver Report to:  
Conservation Division  
State Corporation Commission  
212 No. Market  
Wichita, Kansas

WELL PLUGGING RECORD

Reno County. Sec. 11 Twp. 24S Rge. 4W (E) (W)  
Location as "NE/CNW/SW" or footage from lines C of NW NW NW  
Lease Owner Kanorado Oil and Gas  
Lease Name Johnson Well No. 1  
Office Address 1529 Carey Blvd. Hutchinson, Kans.  
Character of Well (completed as Oil, Gas or Dry Hole) Dry Hole  
Date well completed Dec. 14, 1968  
Application for plugging filed Dec. 14, 1968  
Application for plugging approved Dec. 14, 1968  
Plugging commenced Dec. 14, 1968  
Plugging completed Dec. 14, 1968  
Reason for abandonment of well or producing formation Dry Hole

NORTH

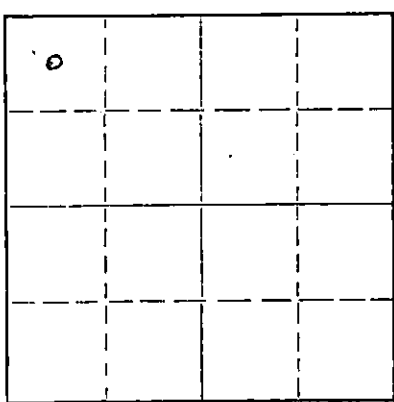

Locate well correctly on above Section Plat

If a producing well is abandoned, date of last production \_\_\_\_\_ 19\_\_\_\_  
Was permission obtained from the Conservation Division or its agents before plugging was commenced? Yes

Name of Conservation Agent who supervised plugging of this well \_\_\_\_\_  
Producing formation Tarkio Depth to top 1676 Bottom 1710 Total Depth of Well 1879 Feet  
Show depth and thickness of all water, oil and gas formations.

OIL, GAS OR WATER RECORDS

CASING RECORD

FORMATION	CONTENT	FROM	TO	SIZE	PUT IN	PULLED OUT
Surface Casing	125' ss each	0	287	7'	287'	0

Describe in detail the manner in which the well was plugged, indicating where the mud fluid was placed and the method or methods used in introducing it into the hole. If cement or other plugs were used, state the character of same and depth placed, from \_\_\_\_\_ feet to \_\_\_\_\_ feet for each plug set.

Hole filled with mud to 260'. Rock bridge set from 260' to 250' and hole circulated with 60 sacks cement. Cement to base of cellar.

RECEIVED  
STATE CORPORATION COMMISSION  
MAR 5 1969  
CONSERVATION DIVISION  
Wichita, Kansas

3-5-69

(If additional description is necessary, use BACK of this sheet)  
Name of Plugging Contractor Petroleum Research  
Address P. O. Box 18 Rantoul, Kansas

STATE OF Kansas COUNTY OF Reno, ss.  
Oscar White d/b/a Kanorado Oil and Gas (Employee or owner or operator) of the above-described well, being first duly sworn on oath, says: That I have knowledge of the facts, statements, and matters herein contained and the log of the above-described well as filed and that the same are true and correct. So help me God.

(Signature) Oscar White  
Oscar White d/b/a  
Kanorado Oil and Gas  
1529 Carey Blvd., Hutchinson, Kansas (Address)

SUBSCRIBED AND SWORN to before me this 5th day of February, 1969

Marvin H. Boor  
Marvin H. Boor  
Notary Public.

My commission expires June 28, 1971