


STATE OF KANSAS
STATE CORPORATION COMMISSION

WELL PLUGGING RECORD

Give All Information Completely
Make Required Affidavit
Mail or Deliver Report to
Conservation Division
State Corporation Comm.
245 North Water
Wichita, KS 67202

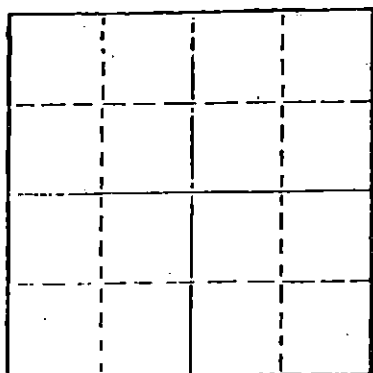

Locate well correctly on above
Section Plot

Edwards County. Sec. 17 Twp. 26S Rge. 16W 1/4
Location as "NE/CNW 1/4 SW 1/4" or footage from lines
NE NE NE
Lease Owner Beren Corporation
Lease Name Monaghan #1 Well No. 1
Office Address 970 Fourth Financial Center, Wichita, Ks. 67202
Character of Well (Completed as Oil, Gas or Dry Hole) Dry Hole

Date Well completed March 16, 19 81
Application for plugging filed March 16, 19 81
Application for plugging approved March 16, 19 81
Plugging commenced 11:30 AM March 16, 19 81
Plugging completed 1:00 PM March 16, 19 81
Reason for abandonment of well or producing formation Dry Hole

If a producing well is abandoned, date of last production 19

Was permission obtained from the Conservation Division or its agents before plugging was commenced? Yes

Name of Conservation Agent who supervised plugging of this well Maurice Leslie
Producing formation Depth to top Bottom Total Depth of Well 4620'
Show depth and thickness of all water, oil and gas formations.

OIL, GAS OR WATER RECORDS

CASING RECORD

FORMATION	CONTENT	FROM	TO	SIZE	PUT IN	PULLED OUT
				8 5/8"	455'	None

Describe in detail the manner in which the well was plugged, indicating where the mud fluid was placed and the method or methods used in introducing it into the hold. If cement or other plugs were used, state the character of same and depth placed, from feet to feet for each plug set.

Filled hole with heavy mud.

Heavy mud to 540' with 40 sacks 50/50 Pozmix through open ended drill pipe. Heavy mud to 450; with 30 sacks through open ended drill pipe. Heavy mud to 40' with Howd plug and 1/2 sack hulls at 40' with solid bridge and 10 sacks to surface. 15 sacks in rathold and 5 sacks in mousehole.

t

(If additional description is necessary, use BACK of this sheet)

Name of Plugging Contractor Sterling Drilling Company, P. O. Box 129, Sterling, Kansas 67579

STATE OF KANSAS COUNTY OF RICE, ss.
F. A. Wuellner (employee of owner) or (owner or operator)
of the above-described well, being first duly sworn on oath, says: That I have knowledge of the facts, statements, and matters herein contained and the log of the above-described well as filed and that the same are true and correct. So help me God.

STERLING DRILLING COMPANY

(Signature) F. A. Wuellner
F. A. Wuellner, Secretary
P. O. Box 129, Sterling, Kansas 67579
(Address)

SUBSCRIBED AND SWORN TO before me this 17th day of March, 19 81.



My commission expires

Bernard Laudermilk
Bernard Laudermilk, Notary Public.

STERLING DRILLING COMPANY
P. O. Box 129.
Sterling, Kansas 67579

15-047-20824-0000

WELL LOG - - - - - MONAGHAN #1
Located: NE NE NE, Section 17-26S-16W, Edwards County,
Kansas

OWNER: Beron Corporation
ROTARY DRILLING CONTRACTOR: Sterling Drilling Company

COMMENCED: March 8, 1981
COMPLETED: March 16, 1981

TOTAL DEPTH: 4620'

LOG
0 - 350 Sand and Gravel
350 - 1069 Shale
1069 - 1082 Anhydrite
1082 - 2125 Shale
2125 - 4620 Lime and Shale

CASING RECORD
Ran 11 joints new 8 5/8", 20# casing.
442.41' pipe set at 455' K.B. Cemented
with 350 sacks 60/40 Pozmix with 2% gel
and 3% cc. Plug down at 10:45 PM, 3-8-81,
by Howco.

Plugged.

Dev

Deviation Surveys:

1° at 2170'
3° at 4620'

RECEIVED
FAC. RECORD DIVISION
1461023 1981
CONSERVATION DIVISION
Wichita, Kansas