


15-047-10079-0000

STATE OF KANSAS  
STATE CORPORATION COMMISSION  
All Information Completely  
Made Required Affidavit  
Mail or Deliver Report to:  
Conservation Division  
State Corporation Commission  
800 Bitting Building  
Wichita, Kansas

### WELL PLUGGING RECORD

Edwards County, Sec. 21 Twp. 26S Rge. 16 (W) (W)

Location as "NE/CNW/SW" or footage from lines NE NE SW  
Lease Owner National Cooperative Refinery Association  
Lease Name Schultz Well No. 1  
Office Address 305 Rule Building, Wichita, Kansas  
Character of Well (completed as Oil, Gas or Dry Hole) Dry Hole  
Date well completed August 7, 19 56  
Application for plugging filed August 7, 19 56  
Application for plugging approved August 8, 19 56  
Plugging commenced August 7, 19 56  
Plugging completed August 7, 19 56  
Reason for abandonment of well or producing formation Dry Hole

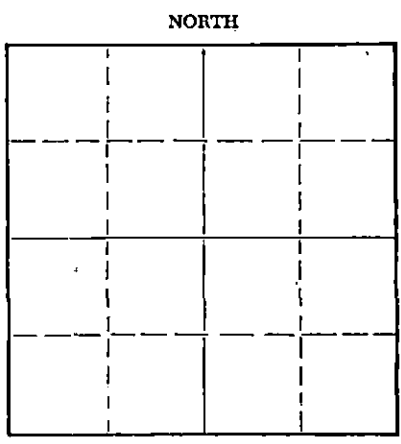

Locate well correctly on above Section Plat

If a producing well is abandoned, date of last production \_\_\_\_\_ 19\_\_\_\_  
Was permission obtained from the Conservation Division or its agents before plugging was commenced? Yes

Name of Conservation Agent who supervised plugging of this well M. A. Rives  
Producing formation \_\_\_\_\_ Depth to top \_\_\_\_\_ Bottom \_\_\_\_\_ Total Depth of Well 4670 Feet  
Show depth and thickness of all water, oil and gas formations.

#### OIL, GAS OR WATER RECORDS

#### CASING RECORD

| FORMATION | CONTENT | FROM | TO | SIZE   | PUT IN | PULLED OUT    |
|-----------|---------|------|----|--------|--------|---------------|
|           |         |      |    | 8 5/8" | 378'   | None-Cemented |
|           |         |      |    |        |        |               |
|           |         |      |    |        |        |               |
Describe in detail the manner in which the well was plugged, indicating where the mud fluid was placed and the method or methods used in introducing it into the hole. If cement or other plugs were used, state the character of same and depth placed, from \_\_\_\_\_ feet to \_\_\_\_\_ feet for each plug set.  
Mudded hole to 300', set plug plus 20 sacks of cement. Mudded hole to 35', set plug plug 10 sacks of cement on up to base of cellar.

RECEIVED  
STATE CORPORATION COMMISSION  
AUG 10 1956

8-10-56

(If additional description is necessary, use BACK of this sheet)  
Name of Plugging Contractor M. B. Armer  
Address Petroleum Building, Wichita, Kansas

STATE OF Kansas, COUNTY OF Sedgwick  
C. R. Sears (employee of owner) or (owner or operator) of the above-described well, being first duly sworn on oath, says: That I have knowledge of the facts, statements, and matters herein contained and the log of the above-described well as filed and that the same are true and correct. So help me God.  
(Signature) C. R. Sears (C. R. Sears)  
305 Rule Building, Wichita, Kansas (Address)

SUBSCRIBED AND SWORN TO before me this 9th day of August, 1956

My commission expires November 26, 1956.  
Nell McComb Notary Public.

PLUGGING  
FILE SEC 21 T 26 R 16w  
BOOK PAGE 88 LINE 9

KANSAS GEOLOGICAL SOCIETY  
 KANSAS WELL LOG BUREAU - KANSAS WELL SAMPLE BUREAU  
 KANSAS GEOLOGICAL SOCIETY BUILDING  
 508 EAST MURDOCK - WICHITA, KANSAS

15-047-10079-0000

COMPANY National Cooperative Refinery Association

SEC. 21 T. 26 R. 16W

FARM Schultz

NO. 1

LOC. NE NE SW

TOTAL DEPTH 4670

COMM. 7/16/56

COMP. 8/7/56

COUNTY Edwards

KANSAS

SHOT OR TREATED

CONTRACTOR Armer, Inc.

ISSUED

CASING

|    |    |      |
|----|----|------|
| 20 | 10 |      |
| 15 | 8  | 378' |
| 12 | 6  |      |
| 13 | 5  |      |

ELEVATION 2098 K.B.

PRODUCTION D & A

FIGURES INDICATE BOTTOM OF FORMATIONS

|                      |      |
|----------------------|------|
| Sand & Clay          | 165  |
| Sand, Shale & Shells | 378  |
| Shale & Red Bed      | 810  |
| Sand, Shale & Shells | 1180 |
| Shale & Shells       | 1291 |
| Anhydrite            | 1335 |
| Shale & Shells       | 2150 |
| Shale & Lime         | 2270 |
| Lime                 | 2375 |
| Lime & Shale         | 3675 |
| Lime                 | 3730 |
| Shale & Lime         | 4005 |
| Lime                 | 4130 |
| Lime & Shale         | 4487 |
| Lime                 | 4583 |
| Shale & Lime         | 4624 |
| Sand, Lime & Chert   | 4650 |
| Chert & Lime         | 4670 |

FORMATION TOPS

|                  |      |
|------------------|------|
| HEEBNER          | 3841 |
| TORONTO          | 3866 |
| BROWN LIME       | 3995 |
| LANSING          | 4005 |
| BASE KANSAS CITY | 4353 |
| MISSISSIPPI      | 4539 |
| KINDERHOOK SHALE | 4588 |
| KINDERHOOK SAND  | 4593 |

I hereby certify that this is a true and correct log of the above described well as shown by the drilling reports.

RECEIVED  
 STATE CORPORATION COMMISSION

ARMER, INC.

AUG 24 1956

CONSERVATION DIVISION  
 Wichita, Kansas

By *[Signature]*

STATE OF KANSAS  
 COUNTY OF SEDGWICK

Subscribed and sworn to before me, a notary public, in and for said County and State this 13th day of August, 1956.

PLUGGING  
 FILE SEC. 21 T. 26 R. 16W  
 BOOK PAGE 88 LINE 9

*[Signature]*  
 Notary Public

My Commission expires October 13, 1956.