


Give All Information Completely
Make Required Affidavit
Mail or Deliver Report to:
Conservation Division
State Corporation Commission
211 No. Broadway
Wichita, Kansas

WELL PLUGGING RECORD 15-047-10017-0000

Edwards County. Sec. 22 Twp. 26 Rge. 16 (K) (W)

Location as "NE/CNW&SW&" or footage from lines NE-NE
Lease Owner Wichita Iron & Metals Corp.
Lease Name WOOD Well No. 1
Office Address Box 13021, Wichita, Kansas
Character of Well (completed as Oil, Gas or Dry Hole) Gas and Oil
Date well completed 11-24 1959
Application for plugging filed 7-22 1966
Application for plugging approved 7-22 1966
Plugging commenced 8-6 1966
Plugging completed 8-11 1966
Reason for abandonment of well or producing formation depleted
If a producing well is abandoned, date of last production 5-30 1966
Was permission obtained from the Conservation Division or its agents before plugging was commenced? Yes

NORTH

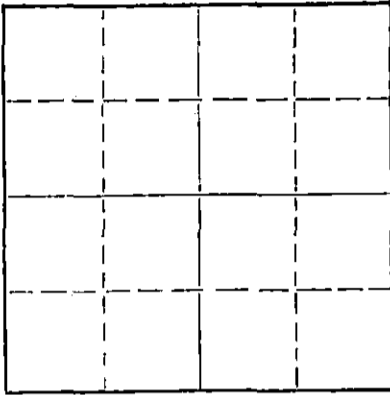

Locate well correctly on above Section Plat

Name of Conservation Agent who supervised plugging of this well Archie Elving
Producing formation Kinderhook Depth to top _____ Bottom _____ Total Depth of Well 4506 Feet
Show depth and thickness of all water, oil and gas formations.

OIL, GAS OR WATER RECORDS

CASING RECORD

FORMATION	CONTENT	FROM	TO	SIZE	PUT IN	PULLED OUT
				8-5/8	1065	None
				13-3/8	102	"
				4-1/2	4504	3190.72

Describe in detail the manner in which the well was plugged, indicating where the mud fluid was placed and the method or methods used in introducing it into the hole. If cement or other plugs were used, state the character of same and depth placed, from _____ feet to _____ feet for each plug set.

Ran sand ; from 4506' to 4350'. Ran 3 sacks of cement from 4350' to 4320'.
Mudded from 4320' to 400'. Rock bridge 400' to 390'. Ran 4 sacks of cement from 390' to 388'. Ran 26 sacks of cement from 388' to 300'.
Mudded from 300' to 35'. Rock and 10 sacks of cement from 35' to base of cellar.

RECEIVED
STATE CORPORATION COMMISSION

AUG 26 1966

CONSERVATION DIVISION
WICHITA, KANSAS

8-26-66

(If additional description is necessary, use BACK of this sheet)
Name of Plugging Contractor Glenn & Smith Pipe Pulling Co.
Address Box 156, Ellinwood, Kansas

STATE OF Kansas, COUNTY OF Sedgwick, ss.
Ray Stekoll (employee of owner) or ~~XXXXXX~~ (operator) of the above-described well, being first duly sworn on oath, says: That I have knowledge of the facts, statements, and matters herein contained and the log of the above-described well as filed and that the same are true and correct. So help me God.
(Signature) By: Ray Stekoll
Wichita Iron & Metals Corp., Inc.
Box 13021, Wichita, Kansas
(Address)

SUBSCRIBED AND SWORN TO before me this 23rd day of August, 1966

My commission expires: December 22, 1966

Evelyn V. North
Evelyn V. North Notary Public.

15-047-10017-0000

WELL LOG BUREAU—KANSAS GEOLOGICAL SOCIETY
50S East Murdock, Wichita, Kansas


COPY

Company- CARTER OIL CO.
Farm- C. R. Wood No. 1

SEC. 22 T. 26 R. 16W
C NE NE

Total Depth. 4506'
Comm. 11-8-59 Comp. 11-24-59
Shot or Treated.
Contractor. Garvey Drlg.
Issued. 1-30-60

County Edwards
KANSAS

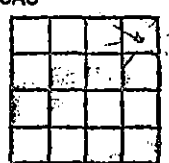

Elevation. 2074' DF

Production. 5,000,000 CFG

CASING:

13 3/8" 102' cem w/150 sx.
8 5/8" 1065' cem w/900 sx.
4 1/2" 4504.08' cem w/225 sx.

Figures indicate Bottom of Formations.

surface sand & shale	280
shale	460
red bed	1057
Anhydrite	1075
shale	1778
shale & lime strks	2000
lime	2400
lime & shale	2700
shale & lime	2837
sandy lime & shale	3090
lime & shale	3340
lime	3508
lime & shale	3660
lime	3720
lime & shale	3876
shale	3904
lime	4228
lime & shale	4364
lime, shale & sand	4385
sand & shale	4389
sand	4407
sand & shale	4436
lime, chert & shale	4462
chert	4473
chert & shale	4506
Total Depth	

TOPS: SCOUT	
Heebner	3758
Toronto	3777
Douglas	3802
Brown Lime	3903
Lansing	3921
Base Kansas City	4248
Cherokee Shale	4357
Cherokee Sand	4382
Viola	4464

RECEIVED
WATER CORPORATION COMMISSION
AUG 26 1966
CONSERVATION DIVISION
Wichita, Kansas