


STATE OF KANSAS
STATE CORPORATION COMMISSION

15-047-20335-0000

WELL PLUGGING RECORD

Give All Information Completely
Make Required Affidavit
Mail or Deliver Report to
Conservation Division
State Corporation Comm.
245 North Water
Wichita, KS 67202

Edwards County, Sec. ²³13 Twp. 26S Rge. 16W E/W
Location as "NE/CNW $\frac{1}{4}$ SW $\frac{1}{4}$ " or footage from lines
NW/4 NW/4 SE/4
Lease Owner Oil Properties Co., Inc.
Lease Name Stegman Well No. #1
Office Address Box 335 Andover, Kansas 67002
Character of Well (Completed as Oil, Gas or Dry Hole)
dry hole - abandoned location
Date Well completed 2-22-78 19
Application for plugging filed 2-25-78 19
Application for plugging approved 3-3-78 19
Plugging commenced 2-23-78 19
Plugging completed 3-1-78 19
Reason for abandonment of well or producing formation

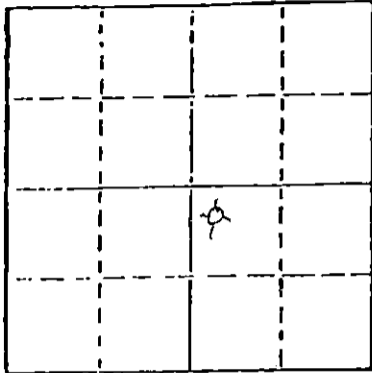

Locate well correctly on above
Section Plat

If a producing well is abandoned, date of last production 19
Was permission obtained from the Conservation Division or
its agents before plugging was commenced? yes

Name of Conservation Agent who supervised plugging of this well Wm T. Owen
Producing formation Depth to top Bottom Total Depth of Well 446'
Show depth and thickness of all water, oil and gas formations.

OIL, GAS OR WATER RECORDS

CASING RECORD

FORMATION	CONTENT	FROM	TO	SIZE	PUT IN	PULLED OUT

Describe in detail the manner in which the well was plugged, indicating where the mud fluid was placed and the method or methods used in introducing it into the hold. If cement or other plugs were used, state the character of same and depth placed, from feet to feet for each plug set.

Cleaned out to 124', connected Allied Cementing Co. pump truck and circulated hole with 40 sacks regular cement, 4% calcium chloride. Filled casing at surface with cement.

RECEIVED
STATE CORPORATION COMMISSION

JUN 19 1978 6-19-78

CONSERVATION DIVISION
Wichita, Kansas

(If additional description is necessary, use BACK of this sheet)

Name of Plugging Contractor Pratt Well Service

STATE OF Kansas COUNTY OF Butler, ss.
David S. Jackman, III (employee of owner) or (owner or operator)
of the above-described well, being first duly sworn on oath, says: That I have knowledge of the facts, statements, and matters herein contained and the log of the above-described well as filed and that the same are true and correct. So help me God.

(Signature)

David S. Jackman III
P.O. Box 335 Andover, Kansas 67002
(Address)

SUBSCRIBED AND SWORN TO before me this 6th day of June, 1978

M. L. Traugott
M. L. Traugott Notary Public.

My commission expires 30 Dec. 1978

M. L. TRAUGOTT
STATE NOTARY PUBLIC
SUMNER COUNTY, KANSAS
MY COMM. EXP. 12-30-78

GABBERT-JONES, INC.
WICHITA, KANSAS
DRILLERS' WELL LOG

Stegman #1
Nw NW SE Sec 23-26S-16W
Edwards County Kansas

15-047-20335-0000

Commenced: 2-7-78

Completed: 2-8-78

OPERATOR: OIL PROPERTIES CO., INC.

Depth		Formation	Remarks
From	to		
0	290	Sand-Topsoil	
290	446	Sand-Shale	
	446 - TB		

STATE OF KANSAS)
) SS
COUNTY OF SEDGWICK)

I, the undersigned, being duly sworn on oath, state that the above Drillers' Well Log is true and correct to the best of my knowledge and belief and according to the records of this office.

GABBERT-JONES, INC.

James S. Sutton II
JAMES S. SUTTON II

Subscribed and sworn to before me this 2nd day of March, 1978.

Elizabeth J. Edwards
ELIZABETH J. EDWARDS-NOTARY PUBLIC

My Commission expires February 6, 1979.

