


15-847-20339-0000

STATE OF KANSAS
STATE CORPORATION COMMISSION

WELL PLUGGING RECORD

Give All Information Completely.
Make Required Affidavit
Mail or Deliver Report to
Conservation Division
State Corporation Comm.
245 North Water
Wichita, KS 67202

Edwards County, Sec. 23 Twp. 26 Rge. 16W E/W
Location as "NE/CNW $\frac{1}{2}$ SW $\frac{1}{2}$ " or footage from lines _____
NE NE SE
Lease Owner Oil Properties Co., Inc.
Lease Name Stegman #1 Well No. _____
Office Address Augusta, Kansas 67010
Character of Well (Completed as Oil, Gas or Dry Hole) _____

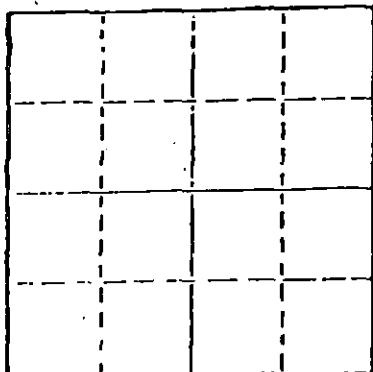

Locate well correctly on above
Section Plot

Date Well completed _____ 19____
Application for plugging filed _____ 19____
Application for plugging approved _____ 19____
Plugging commenced 3/24/78 _____ 19____
Plugging completed 3/30/78 _____ 19____
Reason for abandonment of well or producing formation _____
depleted.
If a producing well is abandoned, date of last production _____ 19____

Was permission obtained from the Conservation Division or
its agents before plugging was commenced? yes

Name of Conservation Agent who supervised plugging of this well Owens
Producing formation _____ Depth to top _____ Bottom _____ Total Depth of Well 4555
Show depth and thickness of all water, oil and gas formations.

OIL, GAS OR WATER RECORDS

CASING RECORD

FORMATION	CONTENT	FROM	TO	SIZE	PUT IN	PULLED OUT
				8-5/8	404	none
				4 1/2"	4554	3520'

Describe in detail the manner in which the well was plugged, indicating where the mud fluid was placed and the method or methods used in introducing it into the hold. If cement or other plugs were used, state the character of same and depth placed, from _____ feet to _____ feet for each plug set.

Sanded to 3925' and ran 4 sacks cement. Shot pipe at 2800', 3602', 3524', pulled 111 joints. Pumped 3 sacks hulls, 25 sacks gel, released plug and pumped 125 sacks common cement with 2% gel and 3% cc.

STATE CORPORATION COMMISSION

PLUGGING COMPLETE.

APR 03 1978

CONSERVATION DIVISION
Wichita, Kansas

4-3-78

(If additional description is necessary, use BACK of this sheet)

Name of Plugging Contractor KELSO CASING PULLING
CHASE, KANSAS

STATE OF KANSAS COUNTY OF RICE, ss.
R. DARRELL KELSO (employee of owner) or (owner or operator)
of the above-described well, being first duly sworn on oath, says: That I have knowledge of the facts, statements, and matters herein contained and the log of the above-described well as filed and that the same are true and correct. So help me God.

(Signature)

R. Darrell Kelso
CHASE, KANSAS

(Address)

SUBSCRIBED AND SWORN TO before me this 31st day of March, 19 78

Margaret Melcher
Notary Public.

My commission expires



GABBERT-JONES, INC.
 WICHITA, KANSAS
 DRILLERS' WELL LOG

15-047-20339-00-00

Stegman #2
 NE-NE-SE Sec 23-26S-16W
 Edwards County Kansas

Commenced: 2-11-78

Completed: 2-23-78

OPERATOR: OIL PROPERTIES CO., INC.

From	Depth to	Formation	Remarks
0	385	Top Soil - Sand	Ran 10 jts of 28#
385	415	Sand-Shale	8 5/8" csg set @ 412'
415	572	Shale-Sand	Cemented w/300 sks
572	1050	Shale-Redbed	Common 2% Gel
1050	1061	Anhy	3% CC PD @ 12:15 pm.
1061	1690	Redbed-Sand-Shale	2-11-78
1690	1898	Shale	
1898	1975	Shale-Lime	
1975	2160	Shale-Sand	Ran 9 jts of New - 132 jts
2160	3015	Shale-Lime	Used 10 1/2" 4 1/2" csg
3015	3150	Lime-Shale	set @ 4550' Pre Flushed
3150	3647	Shale-Lime	w/20 bbls Salt Flush
3647	3840	Lime-Shale	Cemented w/ 150 sks
3840	4551	Lime	50/50 Posmix 18% Salt
	4551 - TD		PD @ 3:05 p.m. 2-23-78

STATE OF KANSAS)
) SS
 COUNTY OF SEDGWICK)

I, the undersigned, being duly sworn on oath, state that the above Drillers' Well Log is true and correct to the best of my knowledge and belief and according to the records of this office.

GABBERT-JONES, INC.

James S. Sutton II
 JAMES S. SUTTON II

Subscribed and sworn to before me this 2nd day of March, 1978.

ELIZABETH J. EDWARDS-NOTARY PUBLIC

My Commission expires February 6, 1979.

