

15-047-20844-0000

WELL PLUGGING RECORD

Give All Information Completely  
 Make Required Affidavit

COUNTY EDWARDS SEC. 11 TWP. 26 RGE. 16 ~~E/W~~  
 Location as in quarters or footage from lines:  
C SE NW


Lease Owner BENSON MINERAL GROUP, INC.  
 Lease Name SALSER D Well No. 1-11  
80202  
 Office Address 1726 CHAMPA ST SUITE 600 DENVER, COLO.  
 Character of Well (Completed as Oil, Gas or Dry Hole): \_\_\_\_\_  
 Date Well Completed 5-12-81  
 Application for plugging filed 8-16-82  
 Plugging commenced 9-14-82  
 Plugging completed 9-15-82  
 Reason for abandonment of well or producing formation DRY

Locate Well  
 correctly on above  
 Section Platt.

Was permission obtained from the Conservation Division or it's  
 Agent's before plugging was commenced? YES

Name of Conservation Agent who supervised plugging of this well STEVE DURRANT  
 Producing formation \_\_\_\_\_ Depth to top \_\_\_\_\_ bottom \_\_\_\_\_ T.D. 4537'  
 Show depth and thickness of all water, oil and gas formations.

OIL, GAS OR WATER RECORDS Casing Record

Formation	Content	From	To	Size	Put in	Pulled Out
				4 1/2"		3,023.10'

Describe in detail the manner in which the well was plugged, indicating where the mud  
 fluid was placed and the method or methods used in introducing it into the hold. If cement  
 or other plugs were used, state the character of same and depth placed, from \_\_\_\_\_ feet  
 to \_\_\_\_\_ feet for each plug set.

SET PLUG AT 4350' - 15' ROCK BRIDGE - 4 SX CEMENT

ALLIED CAME OUT 9-27-82 AND FILLED WITH 3 HULL - 10 JEL - 50 SX CEMENT -  
 1 HULL - 15 JEL - WOODEN PLUG - 100 SX CEMENT 50/50 POZ. WITH 2% JEL 3% C.C.

(If additional description is necessary, use BACK of this sheet)


Name of Plugging Contractor H & H CASING PULLING CO.  
2900 ACRES RD. #107 HUTCHINSON, KS. 67020

STATE OF KANSAS COUNTY OF RENO, ss.  
DONALD H. HURST (employee of owner) or (owner or operator) of the  
 above-described well, being first duly sworn on oath, says: That I have knowledge of the  
 facts, statements, and matters herein contained and the log of the above-described well as  
 filed and that the same are true and correct. So help me God.

(Signature) Donald H. Hurst  
2900 Acres Rd. Apt. 107  
Hutchinson, KS. (Address)

SUBSCRIBED AND SWORN TO this 16th day of Sept. 19 82

My Commission expires: \_\_\_\_\_

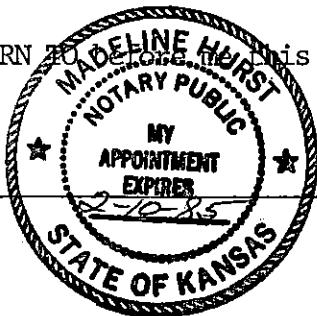

Madeline Hurst  
 Notary Public

RECEIVED  
 OCT 04 1982  
 CONSERVATION DIVISION  
 Wichita, Kansas

10-4-82

KANSAS


WELL COMPLETION REPORT AND  
DRILLER'S LOG

S. 11 T. 26 R. 16 W

Loc. C SENW

County Edwards

640 Acres  
N

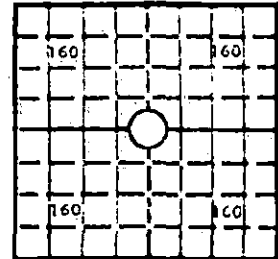

Locate well correctly

Elev.: Gr. 2058

DF \_\_\_\_\_ KB \_\_\_\_\_

API No. 15 — 047 — 20,844-0600  
County Number

Operator  
Benson Mineral Group, Inc.

Address  
1726 Champa St., Suite 600, Denver, CO 80202

Well No. 1-11 Lease Name Salser D

Footage Location  
2310 feet from (N) ~~W~~ line 2310 feet from (E) (W) line

Principal Contractor DaMac Drilling Geologist \_\_\_\_\_

Spud Date 4-10-81 Date Completed 5-12-81 Total Depth 4543 P.B.T.D. 4537

Directional Deviation \_\_\_\_\_ Oil and/or Gas Purchaser \_\_\_\_\_

CASING RECORD

Report of all strings set — surface, intermediate, production, etc.

Purpose of string	Size hole drilled	Size casing set (in O.D.)	Weight lbs/ft.	Setting depth	Type cement	Sacks	Type and percent additives
Surface	12 1/4	8 5/8		489	60-40 POZ	400	3% CaCl
Production	7 7/8	4 1/2	10.5	4537	60-40 POZ	260	10% NaCl

LINER RECORD

PERFORATION RECORD

Top, ft.	Bottom, ft.	Sacks cement	Shots per ft.	Size & type	Depth interval
			2		4460-62
					4404-30

TUBING RECORD

Size	Setting depth	Packer set at

ACID, FRACTURE, SHOT, CEMENT SQUEEZE RECORD

Amount and kind of material used	Depth interval treated
Cement squeeze x 50 sx cmt	4460-62
Acid x 2000 gal 15% reg Hcl	4404-30
Frac x 10,000# 20-40 sn, 15,000# 10-20 sn, 22,000 gal	

INITIAL PRODUCTION 30# cross linked gel

Date of first production \_\_\_\_\_ Producing method (flowing, pumping, gas lift, etc.) \_\_\_\_\_

RATE OF PRODUCTION PER 24 HOURS	Oil	Gas	Water	Gas-oil ratio
	bbls.	MCF	bbls.	CFPB

Disposition of gas (vented, used on lease or sold) \_\_\_\_\_ Producing interval (s) \_\_\_\_\_

INSTRUCTIONS: As provided in KCC Rule 82-2-125, within 90 days after completion of a well, one completed copy of this Drillers Log shall be transmitted to the State Geological Survey of Kansas, 4150 Monroe Street, Wichita, Kansas 67209. Copies of this form are available from the Conservation Division, State Corporation Commission, 245 No. Water, Wichita, Kansas 67202. Phone AC 316-522-2206. If confidential custody is desired, please note Rule 82-2-125. Drillers Logs will be on an open file in the Oil and Gas Division, State Geological Survey of Kansas, Lawrence, Kansas 66044.

Send, Kansas

Phone Plainville 913-434-2812

Phone Kiowa 316-825-4618

# ALLIED CEMENTING CO., INC.

No 30720

Home Office P. O. Box 31.

Russell, Kansas 67665

*Old*

Date	9-27-87	Sec.	11	Twp.	26	Range	16W	Called Out	5:00	On Location	10:00	Job Start	10:15	Finish	11:00
Lease	Wilson		Well No. #	D		Location	Trough Lake to S 28's sec 16			County	Edwards	State	KANS		

Contractor		
Type Job	Old Hole Plus	
Hole Size	7 3/8	T.D.
Csg. Size		Depth
Tbg. Size		Depth
Drill Pipe		Depth
Tool		Depth
Cement Left in Csg.		Shoe Joint
Press Max.		Minimum
Meas Line		Displace
Perf.		

Owner	To Allied Cementing Co., Inc. You are hereby requested to rent cementing equipment and furnish cementer and helper to assist owner or contractor to do work as listed.	
Charge To	B.M.G.	
Street		
City	State	
The above was done to satisfaction and supervision of owner agent or contractor.		

EQUIPMENT		
Pumptrk	No	Cement
67		DREXTON
		Helper
		Jim
Pumptrk	No	Cement
		Helper
Bulktrk	168	Driver
		Mussell
Bulktrk	96	Driver
		KUHNA

Purchase Order No.	X <i>Howard H. Smith</i>	
<b>CEMENT</b>		
Amount Ordered	150 50/3cc 2% gel	
Consisting of	25 gal 46 gals	
Common		
Poz. Mix		
Gel.		
Chloride		
Quickset		
	Sales Tax	

DEPTH of Job		
Reference:	Pumptrk Plus	
	Sub Total	
	Tax	
	Total	

Handling	SEP 29 1987	
Mileage		
	Sub Total	
	Total	
Floating Equipment		

Remarks: Mixed 7 hole 10 gal 50 cement 15 gal 11 gals plus cement  
Plus 100 gal cement