


15-047-00041-0000

WELL PLUGGING RECORD

Give All Information Completely
Make Required Affidavit
Mail or Deliver Report to:
Conservation Division
State Corporation Commission
211 No. Broadway
Wichita, Kansas

NORTH

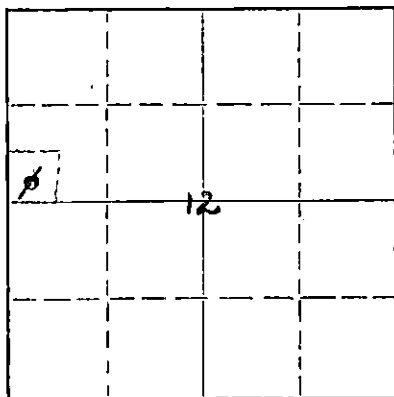

Locate well correctly on above
Section Flat

Edwards

County. Sec. 12 Twp. 26S Rge. 16W (E1) (W)

Location as "NE/CNW/SW" or footage from lines SW/SW/NW

Lease Owner Ambassador Oil Corporation

Lease Name Salser Well No. #1

Office Address 304 Hightower Bldg., Oklahoma City 2, Oklahoma

Character of Well (completed as Oil, Gas or Dry Hole) Oil

Date well completed 1-9 1956

Application for plugging filed Yes 1957

Application for plugging approved Yes 10-30 1957

Plugging commenced 11-8 1957

Plugging completed 11-13 1957

Reason for abandonment of well or producing formation Excess produced salt water made further producing uneconomical.

If a producing well is abandoned, date of last production 1-22 1957

Was permission obtained from the Conservation Division or its agents before plugging was commenced? Yes

Name of Conservation Agent who supervised plugging of this well Mr. M.A. Rives

Producing formation Mississippi Chat Depth to top 4398 Bottom 4420 Total Depth of Well 4765 Feet

Show depth and thickness of all water, oil and gas formations.

OIL, GAS OR WATER RECORDS

CASING RECORD

FORMATION	CONTENT	FROM	TO	SIZE	PUT IN	PULLED OUT
Mississippi Chat	Oil-Salt Water	4391	4440	5 1/2"	4550	2,220'

Describe in detail the manner in which the well was plugged, indicating where the mud fluid was placed and the method or methods used in introducing it into the hole. If cement or other plugs were used, state the character of same and depth placed, from _____ feet to _____ feet for each plug set.

Measured into T.D. 4765'.

Plugging started 11-8-57. Finished 11-13-57.

Plugged off bottom with sand to 4385' and dumped 5 sacks cement.

Circulated and spotted 80 bbls oil. Worked and shot pipe. Mixed and pumped 25 sacks mud and 75 sacks cement in 8 5/8" pipe. Well completed.

Name of Plugging Contractor J.O. Forbes d/b/a Forbes Casing Pulling Co.
Address Box 221, Great Bend, Kansas

STATE OF Kansas COUNTY OF Barton, ss.
J.O. Forbes (employee of owner) or (owner or operator) of the above-described

well, being first duly sworn on oath, says: That I have knowledge of the facts, statements, and matters herein contained and the log of the above-described well as filed and that the same are true and correct. So help me God.

(Signature) J.O. Forbes
Box 221, Great Bend, Kans
(Address)

SUBSCRIBED AND SWORN TO before me this 15th day of November, 1957

My commission expires November 8, 1960.
Notary Public.

RECEIVED
CORPORATION COMMISSION

PLUGGING
FILE SEC 12 T. 26 R. 16 W
BOOK PAGE 57 LINE 45

NOV 20 1957 11-20-57
CONSERVATION DIVISION
Wichita, Kansas

ROTARY DRILLERS LOG

15-047-60041-0000

Operator: Ambassador Oil Corporation
304 Hightower Building
Oklahoma City 2, Oklahoma

Lease Name: G. A. Salser
SW SW NW
Edwards County, Kansas

Clay and sand	0	-	20
Sand and shale	20	-	260
Shale	260	-	295
Red Bed	295	-	735
Red Bed and shale	735	-	1025
Anhydrate	1025	-	1040
Shale	1040	-	1365
Shale and shells	1365	-	2000
Lime and shale	2000	-	3959
Lime	3959	-	4477
Lime and shale	4477	-	4512
Shale and lime crust	4512	-	4551
Cherty lime	4551	-	4686
Shale	4686	-	4765

T. D. 4765

RECEIVED
STATE CORPORATION COMMISSION

OCT 30 1957

CONSERVATION DIVISION
Wichita, Kansas

PLUGGING
FILE SEC 12 T 26 R16W
BOOK PAGE 67 LINE 45