


WELL PLUGGING RECORD 15-151-30027-000

Give All Information Completely  
Make Required Affidavit  
Mail or Deliver Report to  
Conservation Division  
State Corporation Commission  
311 No. Broadway  
Wichita, Kansas

Pratt County. Sec. 2 Twp. 26S Rgs. (E) 15 (W)  
Location as "NE/CNW&SW $\frac{1}{4}$ " or footage from lines 660' FS & EL of Lot 3  
Lease Owner Anadarko Production Company  
Lease Name Reiman "C" Well No. 1  
Office Address Box 351 Liberal, Kansas  
Character of Well (completed as Oil, Gas or Dry Hole) Dry Hole  
Date well completed 8-12 1965  
Application for plugging filed 8-12 1965  
Application for plugging approved 8-12 1965  
Plugging commenced 8-12 1965  
Plugging completed @ 3:00 PM 8-12 1965  
Reason for abandonment of well or producing formation Dry Hole

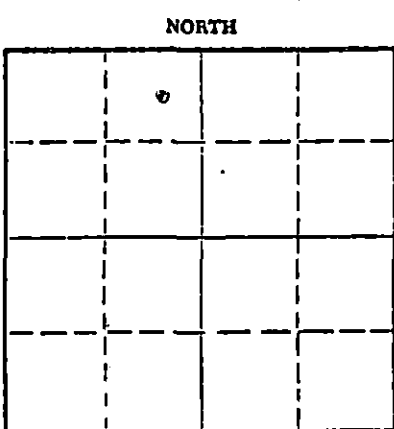

Locate well correctly on above Section Plot

If a producing well is abandoned, date of last production 19  
Was permission obtained from the Conservation Division or its agents before plugging was commenced? Yes - Orally by State Pluggler

Name of Conservation Agent who supervised plugging of this well Archie Elving  
Producing formation None Depth to top - Bottom - Total Depth of Well 4200' Feet  
Show depth and thickness of all water, oil and gas formations.

OIL, GAS OR WATER RECORDS

CASING RECORD

FORMATION	CONTENT	FROM	TO	SIZE	PUT IN	PULLED OUT
				8 5/8	357'	None

Describe in detail the manner in which the well was plugged, indicating where the mud fluid was placed and the method or methods used in introducing it into the hole. If cement or other plugs were used, state the character of same and depth placed, from          feet to          feet for each plug set.  
Filled Hole w/mud to 300', formed bridge, spotted 35 sxs, common cement @ 300', filled Hole w/mud to 50', formed bridge, spotted 15 sxs from 45' to 3' below Ground Level, completed at 3:00 PM 8-12-65.

RECEIVED  
STATE CORPORATION COMMISSION

AUG 18 1965 8-18-65

(If additional description is necessary, use BACK of this sheet)  
Name of Plugging Contractor Braden Drilling Company  
Address 1260 Wichita Plaza Building, Wichita, Kansas

CONSERVATION DIVISION  
Wichita, Kansas

STATE OF Kansas COUNTY OF Seward, ss.  
V. K. Downey (employee of owner) or (owner or operator) of the above-described

well, being first duly sworn on oath, says: That I have knowledge of the facts, statements, and matters herein contained and the log of the above-described well as filed and that the same are true and correct. So help me God.

(Signature) V. K. Downey  
Box 351 Liberal, Kansas (Address)

SUBSCRIBED AND SWORN TO before me this 13th day of August, 1965.

My commission expires           
         Notary Public.  
My Commission Expires Sept. 29, 1968

DRILLER'S LOG

15-151-30027-0000

WELL NAME: Reiman "C" #1; COMPANY OPERATING: Anadarko Production Company  
 ADDRESS of COMPANY: P. O. Box 351; Liberal, Kansas

WELL LOCATION: C 1/4 NE 1/4 NW 1/4,  
4620 ft. North of South line,  
3290 ft. East of West line; Sec. 2, Twp. 26S, Rge. 15W, Pratt County, Kansas

DRILLING STARTED August 1, 1965; DRILLING COMPLETED August 12, 1965  
 WELL COMPLETED August 12, 1965; WELL CONNECTED ---, 19-

ELEVATION: 2035.9 ft. Ground Level; CHARACTER OF WELL (Oil, Gas, or Dry Hole) Dry Hole

OIL OR GAS SANDS OR ZONES - PERFORATIONS - ACIDIZING AND FRACTURING INFORMATION					
Name	From	To	No. of Shots	Gallons Used	Kind Used

CASING RECORD

Size	Amount Set	Sacks of Cement	Amount Pulled
8-5/8"	357'	450 sxs	None

FORMATION RECORD

Formation	Top	Bottom	Formation	Top	Bottom
Sand	0	25			
Red Bed & Shale	25	852			
Coral Stone	852	892			
Shale & Shells	892	1145			
Shale & Red Bed	1145	1350			
Shale & Shells	1350	1810			
Shale & Lime	1810	2050			
Lime & Shale	2050	3935			
Lime	3935	4200			

**RECEIVED**  
 STATE CORPORATION COMMISSION  
 AUG 18 1965  
 CONSERVATION DIVISION  
 Wichita, Kansas

RESULTS of INITIAL PRODUCTION TEST: Dry Hole