


STATE OF KANSAS  
STATE CORPORATION COMMISSION

Give All Information Completely  
Make Required Affidavit  
Mail or Deliver Report to:  
Conservation Division  
State Corporation Commission  
211 No. Broadway  
Wichita, Kansas

WELL PLUGGING RECORD

15-151-00361-00-01

NORTH

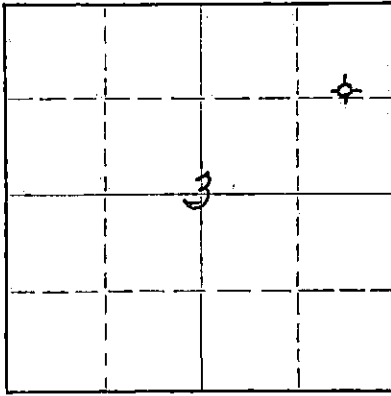

Locate well correctly on above  
Section Plat

Pratt

County. Sec. 3 Twp. 26 Rge. 15 (E) (W)

Location as "NE/CNW&SW&" or footage from lines CS/2-NE-NE

Lease Owner D. R. Lauck Oil Co., Inc.

Lease Name Lemings

Well No. 1

Office Address 302 So. Broadway, Wichita, Kansas

Character of Well (completed as Oil, Gas or Dry Hole) Dry Hole

Date well completed June 15 1960

Application for plugging filed June 17 1960

Application for plugging approved June 20 1960

Plugging commenced June 21 1960

Plugging completed July 2 1960

Reason for abandonment of well or producing formation Non Productive

If a producing well is abandoned, date of last production None 19

Was permission obtained from the Conservation Division or its agents before plugging was commenced? Yes

Name of Conservation Agent who supervised plugging of this well Mr. Fred W. Hampel

Producing formation Mississippi Depth to top 4300 Bottom 4384 Total Depth of Well 4645 Feet

Show depth and thickness of all water, oil and gas formations. PB4390

OIL, GAS OR WATER RECORDS

CASING RECORD

FORMATION	CONTENT	FROM	TO	SIZE	PUT IN	PULLED OUT
Lansing	Dry	3856	4300	8 5/8	363	None
Mississippi	Dry	4300	4384	5 1/2	4645	2269
Kinder Hook	Dry	4384	4430			
Viola	Dry	4430	4458			
Simpson	Dry	4458	4616			
Arbuckle	Dry	4616	4645			

Describe in detail the manner in which the well was plugged, indicating where the mud fluid was placed and the method or methods used in introducing it into the hole. If cement or other plugs were used, state the character of same and depth placed, from feet to feet for each plug set.

Sand 4390-4290  
5 Sx Cement 4290-4260  
Mud 4260- 300  
Rock 300- 280  
20 Sx Cement 280- 220  
Mud 220- 35  
Rock & 105x Cement 35- Cellar base

RECEIVED  
STATE CORPORATION COMMISSION

JUL 15 1960  
CONSERVATION DIVISION  
Wichita, Kansas

7-15-60

(If additional description is necessary, use BACK of this sheet)

Name of Plugging Contractor Glenn & Smith Pipe Bulling Co.

Address Box 114, Ellinwood, Kansas

STATE OF Kansas, COUNTY OF Sedgwick, ss.

John H. Knightley

(employee of owner) Notary Public

well, being first duly sworn on oath, says: That I have knowledge of the facts, statements, and matters herein contained and the log of the above-described well as filed and that the same are true and correct. So help me God.

(Signature)

Elizabeth Gay  
P.O. Box 488 Ellinwood Kansas  
(Address)

SUBSCRIBED AND SWORN TO before me this 14 day of July, 19 60

My commission expires Sept. 14, 1963

Notary Public.