


STATE OF KANSAS
STATE CORPORATION COMMISSION

15-151-00361-0000

WELL PLUGGING RECORD

Give All Information Completely
Make Required Affidavit
Mail or Deliver Report to:
Conservation Division
State Corporation Commission
800 Bitting Building
Wichita, Kansas

NORTH

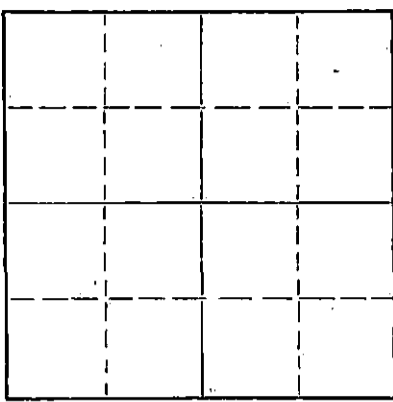

Locate well correctly on above Section Plat

Pratt County. Sec. 3 Twp. 26 Rge. 15W (E) W (W)
Location as "NE/CNW/SW" or footage from lines As per description on
Lease Owner Fred B. Anschutz plugging application.
Lease Name Leming Well No. 1
Office Address 709 Union National Bank Building
Character of Well (completed as Oil, Gas or Dry Hole) Dry Hole
Date well completed July 18, 1955
Application for plugging filed July 18, 1955
Application for plugging approved July 18, 1955
Plugging commenced July 18, 1955
Plugging completed July 18, 1955
Reason for abandonment of well or producing formation Dry Hole

If a producing well is abandoned, date of last production 19
Was permission obtained from the Conservation Division or its agents before plugging was commenced? Yes

Name of Conservation Agent who supervised plugging of this well M. A. Rives - Pratt, Kansas
Producing formation Depth to top Bottom Total Depth of Well 4645 Feet
Show depth and thickness of all water, oil and gas formations.

OIL, GAS OR WATER RECORDS

CASING RECORD

FORMATION	CONTENT	FROM	TO	SIZE	PUT IN	PULLED OUT
				8 5/8"	363'	None

Describe in detail the manner in which the well was plugged, indicating where the mud fluid was placed and the method or methods used in introducing it into the hole. If cement or other plugs were used, state the character of same and depth placed, from feet to feet for each plug set.

Bottom plug set at 300' with 1/4 sack hulls and 23 sacks cement.
Top plug set at 30' with 10 sacks cement.

7-20-55

RECEIVED
STATE CORPORATION COMMISSION
JUL 20 1955

(If additional description is necessary, use BACK of this sheet)
Name of Plugging Contractor Anschutz Drilling Co., Inc.
Address 709 Union National Bank Building

STATE OF Kansas, COUNTY OF Sedgwick, ss.
E. G. Koelling (employee of owner) or (owner or operator) of the above-described well, being first duly sworn on oath, says: That I have knowledge of the facts, statements, and matters herein contained and the log of the above-described well as filed and that the same are true and correct. So help me God.

(Signature) E. G. Koelling - Vice-President
709 Union National Bank Bldg.
(Address)

SUBSCRIBED AND SWORN TO before me this 19th day of July, 1955

My commission expires July 28, 1958.

Charlenne Barbour
Charlenne Barbour Notary Public.

PLUGGING
WEL SEC 3 T 26 R 15W
BOOK PAGE 135 LINE 36

DRILLER'S LOG

15-151-10361-0000

Fred B. Anschutz
 #1 Leming
 4290' from SL and 660' from El
 of
 3-26-15W
 Being located in Lot #1
 Pratt County, Kansas

FROM	TO	
0	220	Sand
220	360	Shale & Red Bed
360	988	Red Rock & Shale
988	1010	Anhydrite
1010	1260	Red Rock, Shale & Shells
1260	1500	Shale & Shells
1500	1620	Shale & Lime
1620	1865	Lime & Shale
1865	2065	Shale & Lime
2065	2165	Lime & Shale
2165	2195	Shale & Lime
2195	2285	Lime
2285	2650	Lime & Shale
2650	2805	Shale & Lime
2805	3868	Lime & Shale
3868	3937	Lime
3937	3993	Lime & Shale
3993	4025	Lime
4025	4291	Lime & Shale
4291	4358	Lime
4358	4439	Lime & Shale
4439	4571	Lime
4571	4645	Lime & Shale
	4645	ROTARY TOTAL DEPTH

COMMENCED: 7-1-55
 COMPLETED: 7-18-55

CASING RECORD:

Set 363' of 8-5/8" surface casing
 with 275 sacks cement.

D & A

STATE OF KANSAS)
) SS
 COUNTY OF SEDGWICK)

I hereby affirm that the above and foregoing is a true and correct copy
 of the log of the #1 Leming located 4290' from SL and 660' from El of Section
 3-26-15W being located in Lot #1, Pratt County, Kansas.

RECEIVED

ANSCHUTZ DRILLING CO., INC.

JUL 20 1955

CONSERVATION DIVISION
 Wichita, Kansas

BY:

E. G. Koelling
 E. G. Koelling
 Vice-President

Subscribed and sworn to before me this 19th day of July, 1955.

Charlene Barbour
 Notary Public
 Charlene Barbour

My Commission Expires: July 28, 1958.

PLUGGING
 FILE SEC-3-Y 26-15W
 BOOK PAGE 135 LINE 36