


WELL PLUGGING RECORD

Give All Information Completely  
Make Required Affidavit  
Mail or Deliver Report to:  
Conservation Division  
State Corporation Commission  
800 Bitting Building  
Wichita, Kansas

Pratt County, Sec. 10 Twp. 26S Rge. (E) 15 (W)

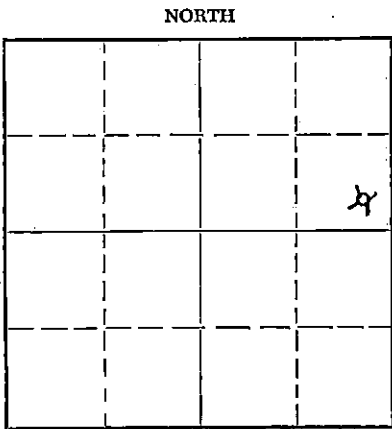

Locate well correctly on above Section Plat

Location as "NE/CNW/SW" or footage from lines SE SE NE  
Lease Owner R. W. RINE DRLG. CO. ETAL.  
Lease Name Curtis Well No. 1  
Office Address 320 Central Bldg., Wichita, Kansas  
Character of Well (completed as Oil, Gas or Dry Hole) Dry Hole  
Date well completed Orig. Dec. 1946; Recompleted May 14, 1954  
Application for plugging filed May 18 1954  
Application for plugging approved May 14, 1954  
Plugging commenced May 14, 1954  
Plugging completed May 14, 1954  
Reason for abandonment of well or producing formation Dry Hole

If a producing well is abandoned, date of last production \_\_\_\_\_ 19\_\_\_\_  
Was permission obtained from the Conservation Division or its agents before plugging was commenced? Yes

Name of Conservation Agent who supervised plugging of this well M. A. Rives, Pratt, Kansas  
Producing formation \_\_\_\_\_ Depth to top \_\_\_\_\_ Bottom \_\_\_\_\_ Total Depth of Well 4610 Feet  
Show depth and thickness of all water, oil and gas formations.

OIL, GAS OR WATER RECORDS

CASING RECORD

FORMATION	CONTENT	FROM	TO	SIZE	PUT IN	PULLED OUT
		0	275	13-3/8	275	None
Viola	Dry	4350	4410			

Describe in detail the manner in which the well was plugged, indicating where the mud fluid was placed and the method or methods used in introducing it into the hole. If cement or other plugs were used, state the character of same and depth placed, from \_\_\_\_\_ feet to \_\_\_\_\_ feet for each plug set.  
Mud from total depth of 4610 to 250' - wood plug and 20 sacks cement at 250' - Heavy mud to 40' - wood plug and 10 sacks cement to bottom of cellar.

This is an old Stanolind Dry Hole completed and abandoned in December, 1946. The old hole was re-opened to test the Viola which was found to be dry. The hole has again been plugged. No log is filed with this report as none is available.

RECEIVED  
STATE CORPORATION COMMISSION  
MAY 17 1954  
CONSERVATION DIVISION  
WICHITA, KANSAS  
5-19-54

(If additional description is necessary, use BACK of this sheet)  
Name of Plugging Contractor The R. W. Rine Drilling Company  
Address 320 Central Bldg., Wichita, Kansas

STATE OF Kansas, COUNTY OF Sedgwick, ss.  
John H. Wilson (employee of owner) or (owner or operator) of the above-described well, being first duly sworn on oath, says: That I have knowledge of the facts, statements, and matters herein contained and the log of the above-described well as filed and that the same are true and correct. So help me God.

(Signature) John H. Wilson  
320 Central Bldg., Wichita, Kansas  
(Address)

SUBSCRIBED AND SWORN to before me this 18th day of May, 1954

My commission expires March 4, 1957  
Betty Jean Clothier Notary Public

PLUGGING  
FILED SEC 10 T 26 S 15 W  
BOOK PAGE 35 LINE 10