


STATE OF KANSAS
STATE CORPORATION COMMISSION

WELL PLUGGING RECORD

15-007-20310-0500

Give All Information Completely
Make Required Affidavit
Mail or Deliver Report to
Conservation Division
State Corporation Comm.
245 North Water
Wichita, KS 67202

Edwards County, Sec. 13 Twp. 26S Rge. 16W E/W
Location as "NE/CNW $\frac{1}{4}$ SW $\frac{1}{4}$ " or footage from lines
SE SE NW

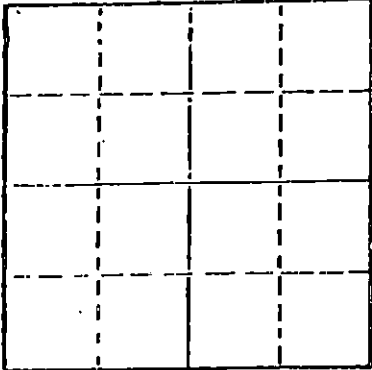

Locate well correctly on above
Section Plot

Lease Owner Beren Corporation
Lease Name Grizzell-Wood "A" Well No. 1
Office Address 970 4th Financial Ctr., Wichita, KS 67202
Character of Well (Completed as Oil, Gas or Dry Hole)
Dry hole

Date Well completed June 20 1978
Application for plugging filed June 20 1978
Application for plugging approved June 20 1978
Plugging commenced June 20 1978
Plugging completed June 20 1978
Reason for abandonment of well or producing formation
D & A

If a producing well is abandoned, date of last production
19

Was permission obtained from the Conservation Division or
its agents before plugging was commenced? Yes, verbally

Name of Conservation Agent who supervised plugging of this well Wm. T. Owen
Producing formation _____ Depth to top _____ Bottom _____ Total Depth of Well _____
Show depth and thickness of all water, oil and gas formations.

OIL, GAS OR WATER RECORDS

CASING RECORD

FORMATION	CONTENT	FROM	TO	SIZE	PUT IN	PULLED OUT

Describe in detail the manner in which the well was plugged, indicating where the mud fluid
was placed and the method or methods used in introducing it into the hold. If cement or other
plugs were used, state the character of same and depth placed, from _____ feet to
_____ feet for each plug set.

First plug set at 410' with 50 sacks
Second plug set at 40' with 24 sacks

RECEIVED
STATE CORPORATION COMMISSION

JUL 03 1978

CONSERVATION DIVISION
Wichita, Kansas

(If additional description is necessary, use BACK of this sheet)

Name of Plugging Contractor Union Drilling Co., Inc.

STATE OF KANSAS COUNTY OF SEDGWICK, ss.
R. D. Messinger (employee of owner) or (owner or operator)
of the above-described well, being first duly sworn on oath, says: That I have knowledge of
the facts, statements, and matters herein contained and the log of the above-described well
as filed and that the same are true and correct. So help me God.


(Signature)

505 Union Center, Wichita, KS
(Address)

SUBSCRIBED AND SWORN TO before me this 21st day of June, 19 78

Cynthia L. Romey
Notary Public.

My commission expires 6-12-82

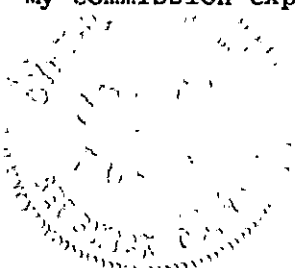

CONTRACTOR'S WELL LOG

15-047-20390-0000

OPERATOR:
CONTRACTOR:
WELL NAME:
LOCATION:

COMMENCED:
COMPLETED:

Beren Corporation
Union Drilling Co., Inc.
Grizzell-Wood "A" #1
SE SE NW Section 13-26S-16W
Edwards County, Kansas
June 10, 1978
June 20, 1978

0	755	Sand and red bed	Set 8-5/8" @ 407' w/300 sx.
755	1835	Shale	
1835	2125	Shale, shells, and lime	
2125	2271	Shale	
2271	3290	Shale and lime	
3290	3412	Shale	
3412	4164	Shale and lime	
4164	4388	Lime and shale	
4388	4409	Lime and chert	
4409	4500	Lime	
	4500	T. D.	

We certify that the above and fore going is a true and correct copy of the log on the Grizzell-Wood "A" #1, SE SE NW Section 13-26S-16W, Edwards County, Kansas.

UNION DRILLING CO., INC.

R. D. Messinger
R. D. Messinger

STATE OF KANSAS)
) SS
COUNTY OF SEDGWICK)

Subscribed and sworn to before me, a Notary Public, in and for the aforesaid County and State as of this 28th day of June, 1978.

My appointment expires:
6-2-82

Cynthia L. Roney
Cynthia L. Roney-Notary Public

RECEIVED
STATE CORPORATION COMMISSION
JUL 03 1978
CONSERVATION DIVISION
Wichita, Kansas