

15-155-19107-0000

STATE OF KANSAS
STATE CORPORATION COMMISSION

WELL PLUGGING RECORD


Give All Information Completely
Make Required Affidavit
Mail or Deliver Report to:
Conservation Division
State Corporation Commission
800 Bittling Building
Wichita, Kansas

OR
FORMATION PLUGGING RECORD

Strike out upper line
when reporting plug-
ging of formations.

Reno County. Sec. 14 Twp. 26S Rge. (E) 9 (W)
CEL NW/4

Location as "NE 1/4 NW 1/4 SW 1/4" or footage from lines.
Lease Owner: Shell Oil Company, Inc.
Lease Name: L. F. Whipple Well No. 2
Office Address: Box 744, Great Bend, Kansas
Character of Well (completed as Oil, Gas or Dry Hole): Oil
Date well completed: July 26 1936
Application for plugging filed: December 5 1945
Application for plugging approved: December 11 1945
Plugging commenced: February 12 1946
Plugging completed: February 18 1946
Reason for abandonment of well or producing formation: Oil Depleted

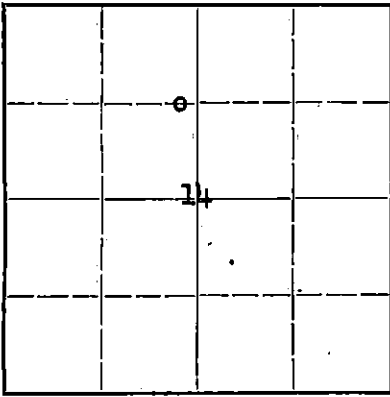

Locate well correctly on above
Section Plat

If a producing well is abandoned, date of last production: October 26 1943
Was permission obtained from the Conservation Division or its agents before plugging was com-
menced? Yes

Name of Conservation Agent who supervised plugging of this well: Ruel Duskee
Producing formation: Viola Depth to top: 4117 Bottom: Total Depth of Well: 4134 Feet
Show depth and thickness of all water, oil and gas formations.

OIL, GAS OR WATER RECORDS

CASING RECORD

Formation	Content	From	To	Size	Put In	Pulled Out
Viola	1790 oil cut 30% BS & Water 6 hrs. flowing	4117	4134	13" 7"	254' 4117	None 2627'

Describe in detail the manner in which the well was plugged, indicating where the mud fluid was placed and the method or methods used in introducing it into the hold. If cement or other plugs were used, state the character of same and depth placed, from _____ feet to _____ feet for each plug set.

Cemented bottom of hole with 6 sax. Mudded hole to bottom of surface pipe (254'). Ran 20 sax cement. Filled surface pipe & capped top with 6 sax cement.

PLUGGING
FILL 15-26-94
35-27

(If additional description is necessary, use BACK of this sheet)

Correspondence regarding this well should be addressed to: Shell Oil Co., Inc.
Address: c/o W. M. Gholson, Box 744, Great Bend, Kansas

STATE CORPORATION
COMMISSION

FEB 27 1946

27-46

STATE OF KANSAS, COUNTY OF BARTON
W. M. Gholson (employee of owner) or owner or operator of the above-described well,

being first duly sworn on oath, says: That I have knowledge of the facts, statements, and matters herein contained and the log of the above-described well as filed and that the same are true and correct. So help me God.

(Signature) *W. M. Gholson*

Box 744, Great Bend, Kansas
(Address)

SUBSCRIBED AND SWORN to before me this 26th day of February, 1946

Betty Postlethwaite
Notary Public

My commission expires 1-24-49