

15-55-19108-6000

STATE OF KANSAS  
STATE CORPORATION COMMISSION

WELL PLUGGING RECORD

Give All Information Completely  
Make Required Affidavit  
Mail or Deliver Report to:  
Conservation Division  
State Corporation Commission  
800 Bittling Building  
Wichita, Kansas


OR

FORMATION PLUGGING RECORD

Strike out upper line  
when reporting plug-  
ging of formations.

RENO County. Sec. 14 Twp. 26S Rge. (E) 9 (W)

Location as "NE $\frac{1}{4}$ NW $\frac{1}{4}$ SW $\frac{1}{4}$ " or footage from lines CNL NW/4  
Lease Owner SHELL OIL CO., INC.  
Lease Name L. F. WHIPPLE Well No. 3  
Office Address BOX 744, GREAT BEND, KANSAS  
Character of Well (completed as Oil, Gas or Dry Hole) OIL  
Date well completed 1-19-37 19  
Application for plugging filed 12-5-45 19  
Application for plugging approved 12-11-45 19  
Plugging commenced 12-5-45 19  
Plugging completed 12-16-45 19  
Reason for abandonment of well or producing formation OIL DEPLETED

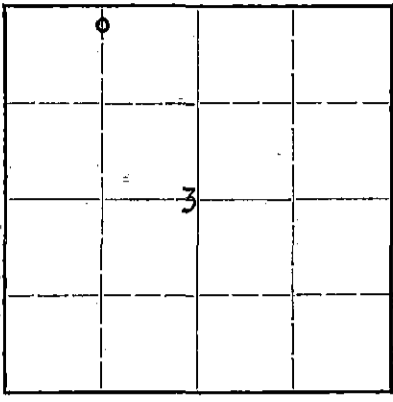

Locate well correctly on above  
Section Plat

If a producing well is abandoned, date of last production 10-1-43 19  
Was permission obtained from the Conservation Division or its agents before plugging was com-  
menced? YES

Name of Conservation Agent who supervised plugging of this well H. W. Kerr  
Producing formation Viola Depth to top 4120 Bottom Total Depth of Well 4126 Feet  
Show depth and thickness of all water, oil and gas formations.

OIL, GAS OR WATER RECORDS

CASING RECORD

Formation	Content	From	To	Size	Put In	Pulled Out
Viola	I. P. 1354.5 oil & 2% BW&W 5 hrs. flowing	4120	4126	13" 7"	180' 4120'	None 2605'

Describe in detail the manner in which the well was plugged, indicating where the mud fluid was placed and the method or methods used in introducing it into the hold. If cement or other plugs were used, state the character of same and depth placed, from.....feet to.....feet for each plug set.

Filled hole with crushed rock from 4126 to 4115 and capped with 6 sax cement. Mudded hole to 180', set 2' wood bridge and capped with 8 feet of rock and 20 sax cement. Filled surface casing with surface soil to within 10' of base of cellar & capped into cellar with 5 sax of cement.

FILE  
BOOK  
14 26 9W  
35 22

(If additional description is necessary, use BACK of this sheet)

Correspondence regarding this well should be addressed to Shell Oil Co., Inc.  
Address c/o W. M. Gholson, Box 744, Great Bend, Kansas

STATE OF KANSAS, COUNTY OF BARTON, ss.

W. M. Gholson (employee of owner) or (owner or operator) of the above-described well, being first duly sworn on oath, says: That I have knowledge of the facts, statements, and matters herein contained and the log of the above-described well as filed and that the same are true and correct. So help me God.

(Signature) *W. M. Gholson*

Box 744, Great Bend, Kansas  
(Address)

SUBSCRIBED AND SWORN TO before me this 23rd day of January 19 46

Betty Postlethwaite  
Notary Public.

My commission expires 1-24-49

1-24-46

15-155-19108-0000

SHELL, L. F. WHIPPLE #3  
CNE NW 14-26S-9W  
LERADO POOL  
RENO COUNTY, KANSAS

CASING RECORD

13" cem 180 with 200 sax  
7" cem 4120 with 300 sax

- 0 - 68 sand & clay
- 143 red sand rock
- 178 red rock
- 220 red sand rock
- 365 shale & anhydrite
- 633 broken lime & shale
- 840 shale
- 890 salt & shale
- 995 shale
- 1018 lime shells
- 1148 shale
- 1160 lime
- 1195 broken lime & shale
- 1255 shale
- 1284 lime
- 1395 lime & shale
- 1433 broken lime, medium
- 1457 lime, hard
- 1465 broken lime
- 1537 lime
- 1608 lime & shale
- 1662 shale & shells
- 1697 lime, medium
- 1727 lime
- 1745 shale
- 1769 lime
- 1831 lime & shale
- 2034 broken lime & shale
- 2040 lime
- 2075 shale
- 2229 shale & shells
- 2385 broken lime & shale
- 2468 lime & shale
- 2538 broken lime
- 2569 lime
- 2630 shale
- 2860 lime & shale
- 2900 red bed
- 2984 shale
- 2999 lime
- 3020 broken lime
- 3290 lime & shale
- 3324 shale  
TOP STANTON LIME 3324
- 3718 lime
- 3796 lime & shale
- 3810 lime
- 3859 shale  
TOP MISS. LIME 3859
- 3900 chat
- 3935 lime  
TOP KINDERHOOK SHALE 3935

- 4080 shale
- 4107 shale & lime
- 4113 shale
- 4118 lime
- 4119 shale
- 4120 shale, pyritic  
TOP TRENTON LIME 4120
- 4121 chert & dolomite
- 4126 dolomite TD

14 26 900  
35 22