

STATE OF KANSAS
STATE CORPORATION COMMISSION

WELL PLUGGING RECORD
OR
FORMATION PLUGGING RECORD

Strike out upper line when reporting plugging off formations.

Give All Information Completely
Make Required Affidavit
Mail or Deliver Report to:
Conservation Division
State Corporation Commission
800 Bittling Building
Wichita, Kansas

Reno County, Sec. 15 Twp. 26 Rge. (E) 9 (W)

Location as "NE $\frac{1}{4}$ NW $\frac{1}{4}$ SW $\frac{1}{4}$ " or footage from lines 330' N. and 330' W. of Cen.

Lease Owner Cities Service Oil Company

Lease Name Mauck Well No. 5

Office Address Bartlesville, Oklahoma

Character of Well (completed as Oil, Gas or Dry Hole) Oil Well

Date well completed June 27, 1937

Application for plugging filed November 4, 1942

Application for plugging approved November 4, 1942

Plugging commenced November 5, 1942


Plugging completed November 10, 1942

Reason for abandonment of well or producing formation Non-commercial

If a producing well is abandoned, date of last production May 3, 1942

Was permission obtained from the Conservation Division or its agents before plugging was commenced? Yes

NORTH

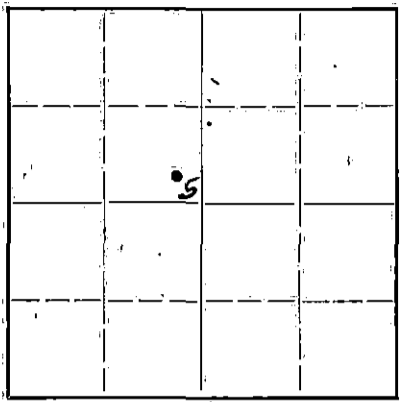

Locate well correctly on above Section Plat

Name of Conservation Agent who supervised plugging of this well Ruel Durkee

Producing formation Viola Depth to top 4141' Bottom Total Depth of Well 4143 Feet

Show depth and thickness of all water, oil and gas formations:


OIL, GAS OR WATER RECORDS

CASING RECORD

Formation	Content	From	To	Size	Put In	Pulled Out
				12-1/2"	309'	0
				7"	4140'	2683'

Describe in detail the manner in which the well was plugged, indicating where the mud fluid was placed and the method or methods used in introducing it into the hold. If cement or other plugs were used, state the character of same and depth placed, from feet to feet for each plug set.

Plugged hole with 6 sacks of cement from 4142' to 4100', mudded hole to 200'; set bridge at 200' and cemented with 15 sacks, mudded and cemented with 10 sacks of cement to surface.

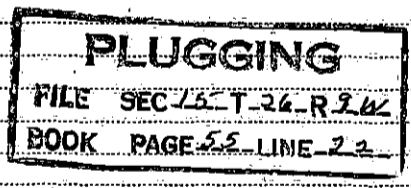

(If additional description is necessary, use BACK of this sheet)

Correspondence regarding this well should be addressed to R. C. Hauber
Address Box 751, Great Bend, Kansas

STATE OF Kansas, COUNTY OF Barton, ss.

J. A. Deffeyes (employee of owner) or (owner or operator) of the above-described well, being first duly sworn on oath, says: That I have knowledge of the facts, statements, and matters herein contained and the log of the above-described well as filed and that the same are true and correct. So help me God.

(Signature)

Box 751, Great Bend, Kansas (Address)

SUBSCRIBED AND SWORN to before me this 24th day of November, 1942

My Commission Expires Sept. 26, 1946

My commission expires

Notary Public

11-27-42