

STATE OF KANSAS
STATE CORPORATION COMMISSION

WELL PLUGGING RECORD


OR
FORMATION PLUGGING RECORD

Strike out upper line
when reporting plug-
ging of formations.

Give All Information Completely
Make Required Affidavit
Mail or Deliver Report to:
Conservation Division
State Corporation Commission
800 Bittling Building
Wichita, Kansas

Reno County, Sec. 15 Twp. 26S, Rge. (E) 9 (W)

Location as "NE $\frac{1}{4}$ NW $\frac{1}{4}$ SW $\frac{1}{4}$ " or footage from lines SW SW NE/4
Lease Owner Shell Oil Co., Inc.
Lease Name Mary Whipple Well No. 9
Office Address Box 744, Great Bend, Kansas
Character of Well (completed as Oil, Gas or Dry Hole) Oil
Date well completed June 25 19 37
Application for plugging filed December 11 19 45
Application for plugging approved December 19 19 45
Plugging commenced January 26 19 46
Plugging completed February 2 19 46
Reason for abandonment of well or producing formation Oil Depleted

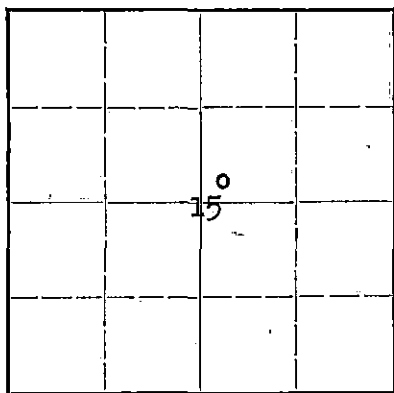

Locate well correctly on above
Section Plat

If a producing well is abandoned, date of last production December 9 19 43
Was permission obtained from the Conservation Division or its agents before plugging was com-
menced? Yes

Name of Conservation Agent who supervised plugging of this well H. W. Kerr
Producing formation Viola Depth to top 4138 Bottom Total Depth of Well 4142 Feet
Show depth and thickness of all water, oil and gas formations.


OIL, GAS OR WATER RECORDS

CASING RECORD

Formation	Content	From	To	Size	Put In	Pulled Out
Viola	583 oil, 536MCF gas/day, & 87 water - flowing 6 hours.	4138	4142	10 $\frac{3}{4}$ " 7"	347' 4138'	None 2536'

Describe in detail the manner in which the well was plugged, indicating where the mud fluid was placed and the method or methods used in introducing it into the hold. If cement or other plugs were used, state the character of same and depth placed, from _____ feet to _____ feet for each plug set.

Cemented bottom of hole from 4142' up into 7" casing
with 6 sax. Mudded hole; set 10' rock bridge at 250';
dumped 20 sax cement. Filled surface casing to top and
capped with 5 sax cement.

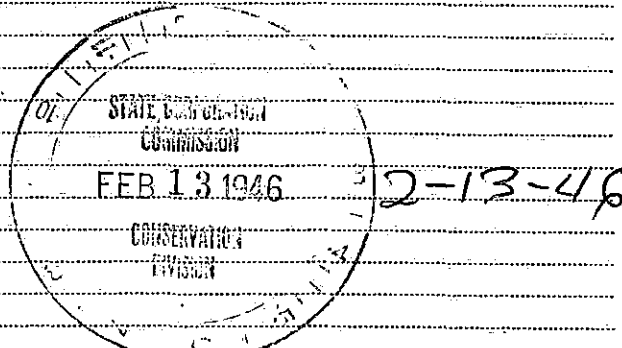

(If additional description is necessary, use BACK of this sheet)

Correspondence regarding this well should be addressed to Shell Oil Co., Inc.
Address c/o W. M. Gholson, Box 744, Great Bend, Kansas

STATE OF KANSAS COUNTY OF BARTON, ss.
W. M. Gholson (employee of owner) or (owner or operator)

being first duly sworn on oath, says: That I have knowledge of the facts, statements, and matters herein contained and the log of the above-described well as filed and that the same are true and correct. So help me God.

(Signature) [Handwritten Signature]
Box 744, Great Bend, Kansas
(Address)

SUBSCRIBED AND SWORN to before me this 12th day of February, 1946

My commission expires 1/24/49

[Handwritten Signature] Notary Public