

STATE OF KANSAS  
STATE CORPORATION COMMISSION

WELL PLUGGING RECORD

Give Information Completely  
Make Required Affidavit  
Mail or Deliver Report to:  
Conservation Division  
State Corporation Commission  
800 Bittling Building  
Wichita, Kansas

FORMATION PLUGGING RECORD

Strike out upper line  
when reporting plug-  
ging off formations.

NORTH

		0	
		15	

Locate well correctly on above  
Section Plat

HENO County. Sec. 15 Twp. 26S Rge. (E) 9 (W)

Location as "NE 1/4 NW 1/4 SW 1/4" or footage from lines NW NW NE 1/4

Lease Owner SHELL OIL CO., INC.

Lease Name MARY WHIPPLE # Well No. 5

Office Address Box 744, Great Bend, Kansas

Character of Well (completed as Oil, Gas or Dry Hole) Oil

Date well completed March 4 19 37

Application for plugging filed December 11 19 45

Application for plugging approved December 19 19 45

Plugging commenced March 8 19 46

Plugging completed March 29 19 46

Reason for abandonment of well or producing formation Oil Depleted

If a producing well is abandoned, date of last production December 5 19 44

Was permission obtained from the Conservation Division or its agents before plugging was commenced? Yes

Name of Conservation Agent who supervised plugging of this well Ruel Durkee

Producing formation Viola Depth to top 4135 Bottom Total Depth of Well 4140 Feet

Show depth and thickness of all water, oil and gas formations.


OIL, GAS OR WATER RECORDS

CASING RECORD

Formation	Content	From	To	Size	Put In	Pulled Out
Viola	1328 oil & 25 water flowing 6 hours, with 1,840M cu ft gas/day	4135	4140	13" 7"	281' 4135'	None 2429'

Describe in detail the manner in which the well was plugged, indicating where the mud fluid was placed and the method or methods used in introducing it into the hold. If cement or other plugs were used, state the character of same and depth placed, from \_\_\_\_\_ feet to \_\_\_\_\_ feet for each plug set.

Cemented bottom of hole with 6 sax.  
Mudded hole to 265'. ran 15' of rock at 265'. ran 40 sax cement at 250'.  
Mudded surface pipe and cemented top of surface pipe with 10 sax.

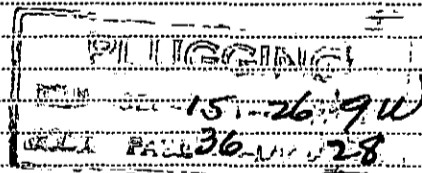

(If additional description is necessary, use BACK of this sheet)

Correspondence regarding this well should be addressed to Shell Oil Co., Inc.  
Address c/o W. M. Gholsen, Box 744, Great Bend, Kansas

STATE OF KANSAS, COUNTY OF BARTON, W. M. GHOLSON (employee of owner) or (owner or operator) of the above-described well,

being first duly sworn on oath, says: That I have knowledge of the facts, statements, and matters herein contained and the log of the above-described well as filed and that the same are true and correct. So help me God.

(Signature) [Handwritten Signature]


Box 744, Great Bend, Kansas (Address)

SUBSCRIBED AND SWORN to before me this 30th day of April

MAY 2 - 19 46

My commission expires January 24, 1949

[Handwritten Signature] Notary Public.

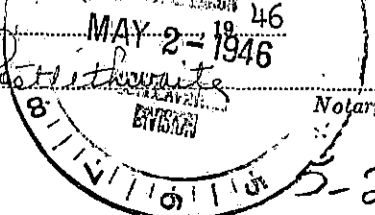

Shell, Mary Whipple #5  
N7 N7 NW 15-25S-9W  
Lorado Pool  
Reno County, Kansas

CASING RECORD

13" cem 281 with 300 sex  
7" cem 4135 with 300 sex

- 0 - 10 sand
- 82 sand & clay
- 1485 red rock Drig 9" hole.
- 1125 soft shale & shells
- 1270 shale & shells
- 1289 lime
- 1485 broken lime
- 1505 lime
- 1535 broken lime
- 1547 lime
- 1575 broken lime
- 1643 lime
- 1656 shale
- 1710 broken lime
- 1730 lime
- 1750 broken lime
- 1836 lime
- 1857 broken lime
- 1905 lime
- 1995 broken lime
- 2015 red shale
- 2098 shale
- 2184 lime shells & shale
- 2197 lime
- 2284 shale & shells
- 2324 shale & lime
- 2385 shale & shells
- 2504 shale & lime
- 2518 lime
- 2654 broken lime & shale
- 2667 lime
- 2785 shale & shells
- 2799 sandy shale
- 2876 broken lime
- 2904 lime
- 2946 shale & lime
- 2960 lime
- 2978 shale & shells
- 3018 lime
- 3033 broken lime
- 3041 lime
- 3074 lime & shale
- 3275 lime
- 3331 lime & shale
- 3342 broken lime

- TOP STANTON LIME 3342
- 3652 lime
- 3760 lime & shale
- 3841 shale
- 3870 shale
- TOP CHAT 3870
- 3912 chat
- 3938 lime
- 3950 lime & shale
- TOP KINDERHOOK SHALE 3950
- 4126 shale
- 4129 lime
- 4132 shale
- 4132 conglomerate
- 4134 dolomite & chert nodules
- 4134=4137 SLC
- TOP TRENTON LIME 4135
- 4140 dolomite TD

PLUGGING  
FILE 15 26 94  
BOOK PAGE 36 LINE 28

