

STATE OF KANSAS
STATE CORPORATION COMMISSION


WELL PLUGGING RECORD

Give All Information Completely
Make Required Affidavit
Mail or Deliver Report to:
Conservation Division
State Corporation Commission
800 Bitting Building
Wichita, Kansas

OR
FORMATION PLUGGING RECORD

Strike out upper line
when reporting plug-
ging off formations.

NORTH

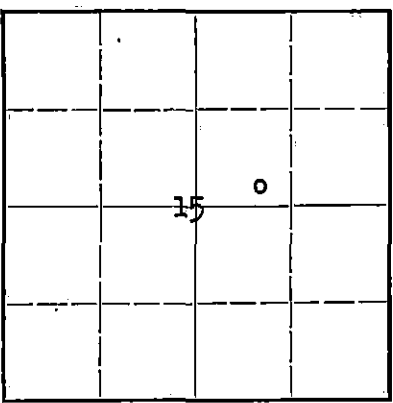

Locate well correctly on above
Section Flat

Reno County. Sec. 15 Twp. 26S. Rge. (E) 9 (W)
Location as "NE 1/4 NW 1/4 SW 1/4" or footage from lines. SE SW NE 15-26S-9W
Lease Owner. Shell Oil Co., Inc.
Lease Name. Mary Whipple Well No. 4
Office Address. Box 744, Great Bend, Kansas
Character of Well (completed as Oil, Gas or Dry Hole). Oil
Date well completed. February 18 1937
Application for plugging filed. December 11 1945
Application for plugging approved. December 19 1945
Plugging commenced. February 6 1946
Plugging completed. February 11 1946
Reason for abandonment of well or producing formation. Oil Depleted

If a producing well is abandoned, date of last production. April 2 1945
Was permission obtained from the Conservation Division or its agents before plugging was commenced? Yes

Name of Conservation Agent who supervised plugging of this well. Ruel Durkee
Producing formation. Viola Depth to top. 4141 Bottom. Total Depth of Well. 4146 Feet
Show depth and thickness of all water, oil and gas formations.

OIL, GAS OR WATER RECORDS

CASING RECORD


Formation	Content	From	To	Size	Put In	Pulled Out
Viola	646 oil & 80 water 6 hours flowing	4141	4146	10 3/4" 7"	300 4141	None 2639

Describe in detail the manner in which the well was plugged, indicating where the mud fluid was placed and the method or methods used in introducing it into the hold. If cement or other plugs were used, state the character of same and depth placed, from feet to feet for each plug set.

Cemented bottom of hole with 6 sax - 4146 to 4136.
Mudded hole and ran 20 sax cement at bottom of surface pipe (300'). Filled surface pipe and capped at top with 6 sax cement.

PLUGGING
FILE 15 26 9 W
Box 744 36 27

2-27-46

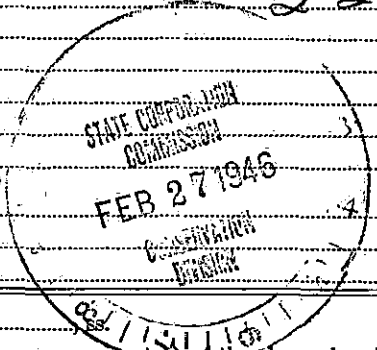

(If additional description is necessary, use BACK of this sheet)
Correspondence regarding this well should be addressed to. Shell Oil Co., Inc.
Address. c/o W. M. Gholson, Box 744, Great Bend, Kansas

STATE OF KANSAS, COUNTY OF BARTON
W. M. Gholson (employee of owner) or (owner or operator) of the above-described well,
being first duly sworn on oath, says: That I have knowledge of the facts, statements, and matters herein contained and the log of the above-described well as filed and that the same are true and correct. So help me God.

(Signature) [Signature]

Box 744, Great Bend, Kansas (Address)

SUBSCRIBED AND SWORN to before me this 26th day of February, 1946.

My commission expires 1-24-49

[Signature] Notary Public