

STATE OF KANSAS
STATE CORPORATION COMMISSION

WELL PLUGGING RECORD


OR
FORMATION PLUGGING RECORD

Strike out upper line when reporting plugging of formations.

Give All Information Completely
Make Required Affidavit
Mail or Deliver Report to:
Conservation Division
State Corporation Commission
800 Bitting Building
Wichita, Kansas

RENO County Sec. 15 Twp. 26S Rge. 9 (E) (W)
Location as "NE $\frac{1}{4}$ NW $\frac{1}{4}$ SW $\frac{1}{4}$ " or footage from lines SW NW NE 1/4
Lease Owner Shell Oil Co., Inc.
Lease Name Mary Whipple Well No. 3
Office Address Box 744, Great Bend, Kansas
Character of Well (completed as Oil, Gas or Dry Hole) Oil
Date well completed December 16 19 36
Application for plugging filed December 11 19 45
Application for plugging approved December 19 19 45
Plugging commenced January 12 19 46
Plugging completed January 25 19 46
Reason for abandonment of well or producing formation Oil Depleted

NORTH

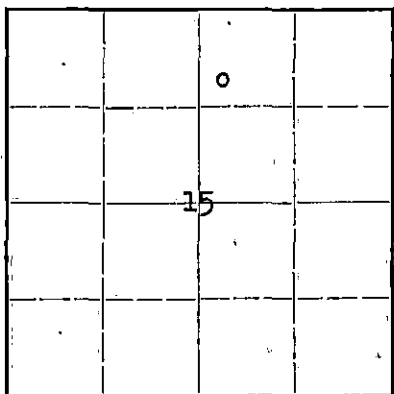

Locate well correctly on above Section Plat

If a producing well is abandoned, date of last production April 21 19 44
Was permission obtained from the Conservation Division or its agents before plugging was commenced? Yes

Name of Conservation Agent who supervised plugging of this well H. W. Kerr
Producing formation Viola Depth to top 4136 Bottom Total Depth of Well 4144 Feet
Show depth and thickness of all water, oil and gas formations.

OIL, GAS OR WATER RECORDS

CASING RECORD

Formation	Content	From	To	Size	Put In	Pulled Out
Viola	1323 oil, 8% water, flowing 6 hours.	4136	4144	13"	320'	None
				7"	4136'	2713'

Describe in detail the manner in which the well was plugged, indicating where the mud fluid was placed and the method or methods used in introducing it into the hold. If cement or other plugs were used, state the character of same and depth placed, from feet to feet for each plug set.

Dumped 6 sax cement on bottom. Mudded hole. Put in 10' rock bridge from 260' to 250'. Dumped 20 sax cement; filled to 8' and capped with 8 sax cement.

15 26 9W
36 26

FEB - 1 1946

2-1-46

(If additional description is necessary, use BACK of this sheet)

Correspondence regarding this well should be addressed to Shell Oil Co., Inc.
Address c/o W. M. Gholson, Box 744, Great Bend, Kansas

STATE OF KANSAS, COUNTY OF BARTON, ss.
W. M. Gholson (employee of owner or contractor) of the above-described well,

being first duly sworn on oath, says: That I have knowledge of the facts, statements, and matters herein contained and the log of the above-described well as filed and that the same are true and correct. So help me God.

(Signature) *W. M. Gholson*

Box 744, Great Bend, Kansas (Address)

SUBSCRIBED AND SWORN to before me this 31st day of January 1946

Betty Peatlethwait

Notary Public.

My commission expires 1-24-49