

STATE OF KANSAS
STATE CORPORATION COMMISSION


WELL PLUGGING RECORD

OR
FORMATION PLUGGING RECORD

Strike out upper line
when reporting plug-
ging off formations.

Give All Information Completely
Make Required Affidavit
Mail or Deliver Report to:
Conservation Division
State Corporation Commission
800 Bitting Building
Wichita, Kansas

RENO County. Sec. 15 Twp. 26S Rge. (E) 9 (W)
Location as "NE 1/4 NW 1/4 SW 1/4" or footage from lines. NW NW SE 1/4
Lease Owner. Shell Oil Co., INC.
Lease Name. E. L. Adkins Well No. 2
Office Address. Box 744, Great Bend, Kansas
Character of Well (completed as Oil, Gas or Dry Hole). Oil
Date well completed. July 29 19 37
Application for plugging filed. December 11 19 45
Application for plugging approved. December 19 19 45
Plugging commenced. January 17 19 46
Plugging completed. January 25 19 46
Reason for abandonment of well or producing formation. Oil Depleted
If a producing well is abandoned, date of last production. March 4 19 45
Was permission obtained from the Conservation Division or its agents before plugging was com-
menced? Yes

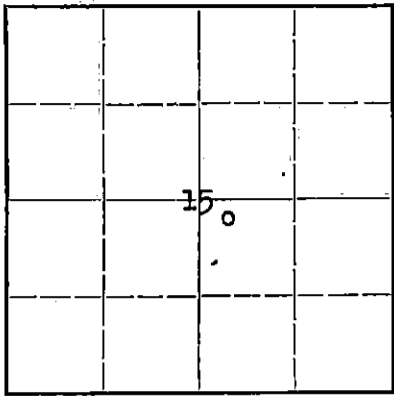

Locate well correctly on above
Section Plat

Name of Conservation Agent who supervised plugging of this well. H. W. Kerr
Producing formation. Viola Depth to top. 4142 Bottom. Total Depth of Well. 4144 Feet
Show depth and thickness of all water, oil and gas formations.


OIL, GAS OR WATER RECORDS

CASING RECORD

Formation	Content	From	To	Size	Put In	Pulled Out
Viola	262.5 oil & 22 water flow- ing 4 hours	4142	4144	10 3/4" 7"	352' 4142'	None 2644'

Describe in detail the manner in which the well was plugged, indicating where the mud fluid was placed and the method or methods used in introducing it into the hold. If cement or other plugs were used, state the character of same and depth placed, from.....feet to.....feet for each plug set.

Cemented bottom of hole with 6 sax cement. Mudded hole to bottom of surface pipe (352') and ran 20 sax cement & crushed rock. Filled surface pipe and capped with 6 sax cement.

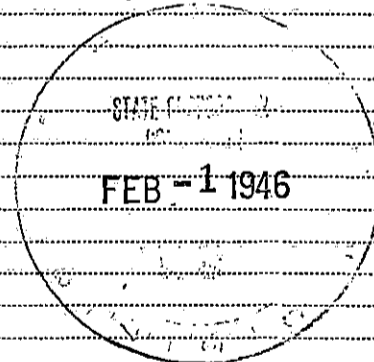

15 26 9W
36 23

(If additional description is necessary, use BACK of this sheet)

Correspondence regarding this well should be addressed to. Shell Oil Co., Inc.
Address. c/o W. M. Gholson, Box 744, Great Bend, Kansas

STATE OF KANSAS, COUNTY OF RENO, ss.
W. M. Gholson (employee of owner) or operator of the above-described well,

being first duly sworn on oath, says: That I have knowledge of the facts, statements, and matters herein contained and the log of the above-described well as filed and that the same are true and correct. So help me God.

(Signature) [Handwritten Signature]

Box 744, Great Bend, Kansas
(Address)

SUBSCRIBED AND SWORN to before me this 31st day of January, 19 46

[Handwritten Signature] Notary Public.

My commission expires 1-24-49

Shell, E. L. Adkins #2
NW NW SE 15-26S-9W
Lerado Pool
Reno County, Kansas

CASING RECORD

10 $\frac{3}{4}$ " cem 352 with 300 sax
7" cem 4142 with 300 sax

0 - 150 surface soil
252 red rock
258 sand
352 red rock
744 red rock & shale Drlg 9" hole
828 shale
1363 salt & shale
1675 lime & shale
1790 broken lime
2315 lime & shale
2397 shale
2476 lime & shale
2500 lime
2534 lime & shale
2572 lime
2623 shale & lime
2673 broken lime
2842 shale & lime
2897 lime
2925 shale
3020 shale & broken lime
3060 lime
3122 broken lime
3272 lime
3330 broken lime
3333 lime SLC
TOP STANTON LIME 3350
3665 lime
3670 broken lime
3820 lime
3881 shale
TOP MISS. CHAT 3881
3931 chat
3964 lime
TOP KINDERHOOK SHALE 3964
4128 shale
4130 lime snells
4135 shale
TOP KINDERHOOK LIME 4135
4139 lime
4142 shale
4143 conglomerate
TOP TRENTON LIME 4142
4144 dolomite TD

JAN 28 1946

15 26 9W
36 23