

STATE OF KANSAS
STATE CORPORATION COMMISSION

WELL PLUGGING RECORD

Give All Information Completely
Make Required Affidavit
Mail or Deliver Report to:
Conservation Division
State Corporation Commission
800 Bitting Building
Wichita, Kansas

FORMATION PLUGGING RECORD

Strike out upper line
when reporting plug-
ging off formations.

Reno County. Sec. 15 Twp. 26S Rge. (E) 9 (W)

Location as "NE 1/4 NW 1/4 SW 1/4" or footage from lines. NE NW SE/4

Lease Owner. Shell Oil Co., Inc.

Lease Name. E. L. Adkins Well No. 1

Office Address. BOX 744, Great Bend, Kansas

Character of Well (completed as Oil, Gas or Dry Hole). Oil

Date well completed. April 12 19 37

Application for plugging filed. December 11 19 45

Application for plugging approved. December 19 19 45


Plugging commenced. February 1 19 46

Plugging completed. February 6 19 46

Reason for abandonment of well or producing formation. Oil Depleted

If a producing well is abandoned, date of last production. March 24 19 45

Was permission obtained from the Conservation Division or its agents before plugging was commenced? Yes

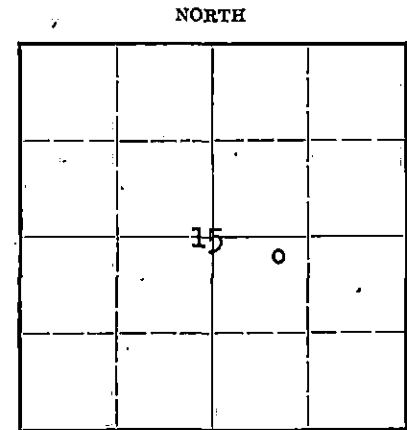

Locate well correctly on above
Section Plat

Name of Conservation Agent who supervised plugging of this well. H. W. Kerr

Producing formation. Viola Depth to top. 4143 Bottom. Total Depth of Well. 4146 Feet

Show depth and thickness of all water, oil and gas formations.

OIL, GAS OR WATER RECORDS


CASING RECORD

Formation	Content	From	To	Size	Put In	Pulled Out
Viola	646 oil; 1010M cu. ft. gas; & 160 water, 6 hours flowing.	4143	4146	10 3/4"	282' 4143'	None 2611'

Describe in detail the manner in which the well was plugged, indicating where the mud fluid was placed and the method or methods used in introducing it into the hold. If cement or other plugs were used, state the character of same and depth placed, from _____ feet to _____ feet for each plug set.

Cemented bottom of hole with 6 sax from 4146 to 4110. Mudded hole to bottom of surface pipe (282'). Cemented off bottom of surface pipe with 20 sax. Filled surface pipe and capped with 8 sax of cement.

15 26 9W
36 22

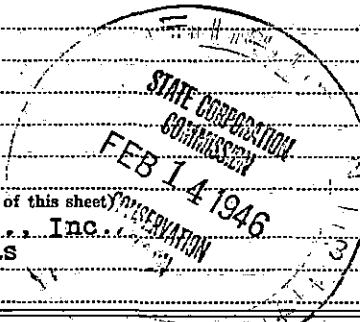

Correspondence regarding this well should be addressed to. Shell Oil Co., Inc.
Address. c/o W. M. Gholson, Box 744, Great Bend, Kansas

STATE OF KANSAS COUNTY OF BARTON
W. M. Gholson (employee of owner) 2606 owner or operator

being first duly sworn on oath, says: That I have knowledge of the facts, statements, and matters herein contained and the log of the above-described well as filed and that the same are true and correct. So help me God.

(Signature) [Signature] Box 744, Great Bend, Kansas (Address)

SUBSCRIBED AND SWORN to before me this 13th day of February, 19 46

My commission expires 1-24-49 [Signature] Notary Public.