


STATE OF KANSAS  
STATE CORPORATION COMMISSION

WELL PLUGGING RECORD  
OR  
FORMATION PLUGGING RECORD

Strike out upper line when reporting plugging off formations.

Give All Information Completely  
Make Required Affidavit  
Mail or Deliver Report to:  
Conservation Division  
State Corporation Commission,  
800 Bittling Building,  
Wichita, Kansas

Reno County. Sec. 15 Twp. 26 Rge. (E) 9 (W)  
Location as "NE 1/4 NW 1/4 SW 1/4" or footage from lines 330' from N. 330' from W.  
Lease Owner The Ohio Oil Company  
Lease Name W C Lawson Well No. 3  
Office Address McPherson, Kansas, Box 710  
Character of Well (Completed as Oil, Gas or Dry Hole) Oil  
Date, well completed March 19, 1937  
Application for plugging filed 1937  
Application for plugging approved September 9, 1938  
Plugging Commenced October 18, 1938  
Plugging Completed October 20, 1938  
Reason for abandonment of well or producing formation Encroachment of salt water and inability to make 1/6% of allowable  
If a producing well is abandoned, date of last production August 31, 1938  
Was permission obtained from the Conservation Division or its agents before plugging was commenced? Yes

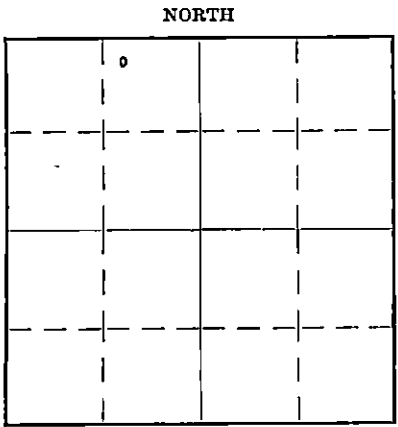

Locate well correctly on above Section Plat

Name of Conservation Agent who supervised plugging of this well Guy Wiershing  
Producing formation Viola Lime Depth to top 4152 Bottom 4159 Total Depth of Well 4159 Feet  
Show depth and thickness of all water, oil and gas formations.

OIL, GAS OR WATER RECORDS

CASING RECORD

Formation	Content	From	To	Size	Put In	Pulled Out
Viola Lime	Oil & Water	4152	4159	15 1/2 7	351 4152	None 1742


Describe in detail the manner in which the well was plugged, indicating where the mud fluid was placed and the method or methods used in introducing it into the hole. If cement or other plugs were used, state the character of same and depth placed, from \_\_\_\_\_ feet to \_\_\_\_\_ feet for each plug set.

Cemented bottom of hole from 4159 to 4137, 15' above viola line. Filled with heavy mud between plugs from 4137 to top of hole. Impossible to set plug at top of chat. Plug, rocks & 15' cement below fresh water at 355'

Plug, rocks & 10' cement at base of cellar. Cement was dumped with dump bailer except at base of cellar.

Mud and rocks were broken in small pieces and dropped in hole.

PLUGGING  
FILE SEC 15 TWP 26 R 9 W  
BOOK PAGE 33 LINE 34

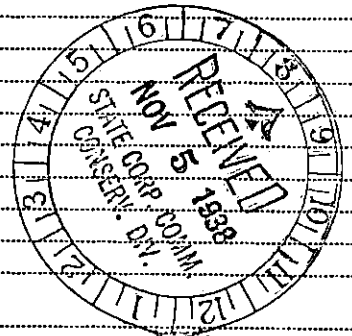

(If additional description is necessary use BACK of this sheet)

Correspondence regarding this well should be addressed to The Ohio Oil Company  
Address Box 710, McPherson, Kansas.

STATE OF Kansas, COUNTY OF Sedgwick, ss.  
Bruce Aug (employee of owner) or (owner or operator) of the above-described well, being first duly sworn on oath, says: That I have knowledge of the facts, statements, and matters herein contained and the log of the above-described well as filed and that the same are true and correct. So help me God.

(Signature) Bruce Aug  
Box 710 McPherson Kansas  
(Address)

SUBSCRIBED AND SWORN to before me this 4 day of Nov, 1938

My commission expires Feb. 11, 1941.  
A. J. McClintock Notary Public.