

STATE OF KANSAS  
STATE CORPORATION COMMISSION

WELL PLUGGING RECORD  
OR  
FORMATION PLUGGING RECORD

Strike out upper line when reporting plugging of formations.

Give All Information Completely  
Make Required Affidavit  
Mail or Deliver Report to:  
Conservation Division  
State Corporation Commission,  
800 Bittling Building,  
Wichita, Kansas

Reno County. Sec. 15 Twp. 26 Rge. (E) 9 (W)  
Location as "NE 1/4 NW 1/4 SW 1/4" or footage from lines 330' from S, 330' from W.

Lease Owner The Ohio Oil Company  
Lease Name W C Lawson Well No. 4

Office Address Box 710, McPherson, Kansas.

Character of Well (Completed as Oil, Gas or Dry Hole) Oil

Date, well completed May 2, 1937

Application for plugging filed 1937

Application for plugging approved September 9, 1938


Plugging Commenced October 17, 1938

Plugging Completed October 18, 1938

Reason for abandonment of well or producing formation Encroachment of salt water and inability to make 1/6% of allowable

If a producing well is abandoned, date of last production August 31, 1938

Was permission obtained from the Conservation Division or its agents before plugging was commenced? Yes

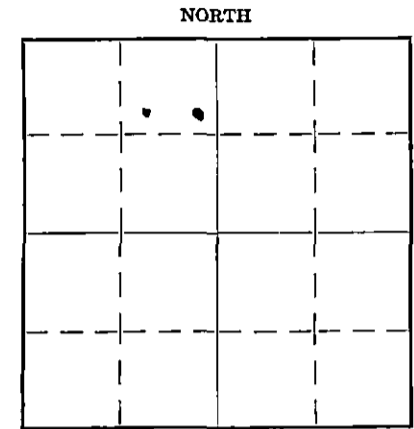

Locate well correctly on above Section Flat

Name of Conservation Agent who supervised plugging of this well Guy Wiershing

Producing formation Viola Lime Depth to top 4148 Bottom 4150 Total Depth of Well 4150 Feet

Show depth and thickness of all water, oil and gas formations.

OIL, GAS OR WATER RECORDS

CASING RECORD


Formation	Content	From	To	Size	Put In	Pulled Out
Viola Lime	Oil & Water	4148	4150	15 1/2 7	333 4148	None 1651

Describe in detail the manner in which the well was plugged, indicating where the mud fluid was placed and the method or methods used in introducing it into the hole. If cement or other plugs were used, state the character of same and depth placed, from...feet to...feet for each plug set.

Cemented at bottom of hole from 4150 to 4133', 15' above viola. Filled with heavy mud between plugs from 4133' to top of hole. Plugs, rocks & 15' cement at top of chat 3904 to 3889'. Plugs, rocks and 15' cement above surface pipe at 350'.

Plugs, rocks and 10' cement at base of cellar. The cement was dumped with a dump bailer except at base of cellar. The mud and rocks were broken in small pieces and dropped in the hole

PLUGGING  
FILE - 15-26-R-264  
BOOK PAGE 33 LINE 25

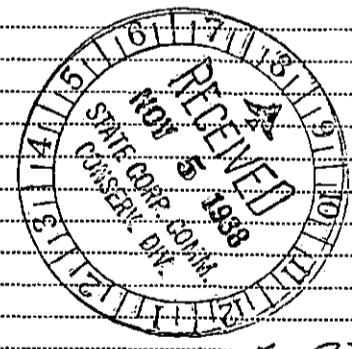

11-5-38

(If additional description is necessary use BACK of this sheet)

Correspondence regarding this well should be addressed to The Ohio Oil Company

Address Box 710, McPherson, Kansas.

STATE OF Kansas, COUNTY OF Sedgwick, ss.

Bruce Aug (employee of owner) or (owner or operator) of the above-described well, being first duly sworn on oath, says: That I have knowledge of the facts, statements, and matters herein contained and the log of the above-described well as filed and that the same are true and correct. So help me God.

(Signature) B. Aug

Box 710 McPherson Kansas (Address)

SUBSCRIBED AND SWORN to before me this 4 day of Nov., 1938.

My commission expires Feb. 11, 1941. A. J. McClintock Notary Public.