


STATE OF KANSAS
STATE CORPORATION COMMISSION

WELL PLUGGING RECORD

Give All Information Completely
Make Required Affidavit
Mail or Deliver Report to:
Conservation Division
State Corporation Commission
800 Bittling Building
Wichita, Kansas

FORMATION PLUGGING RECORD

Strike out upper line
when reporting plugging
of formations.

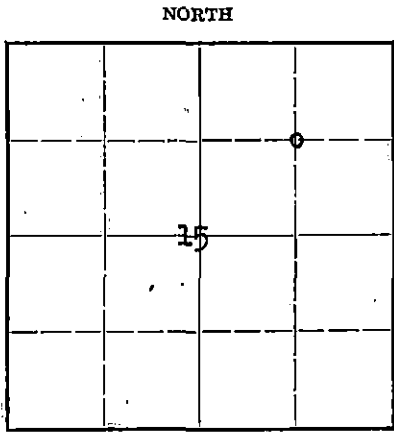

Locate well correctly on above
Section Plat

Reno County. Sec. 15 Twp. 26S Rge. (E) 9 (W)
Location as "NE 1/4 NW 1/4 SW 1/4" or footage from lines. C NE/4
Lease Owner Bethlehem Supply Co. (formerly Shell Oil Co., Inc.)
Lease Name Mary Whipple Well No. 8
Office Address Box 2171, Tulsa, Oklahoma
Character of Well (completed as Oil, Gas or Dry Hole) Oil
Date well completed May 31 19 37
Application for plugging filed December 11 19 45
Application for plugging approved December 19 19 45
Plugging commenced *January 8 19 46
Plugging completed *January 17, 1946 & January 28 19 47
Reason for abandonment of well or producing formation Oil Depleted

If a producing well is abandoned, date of last production April 12 19 45
Was permission obtained from the Conservation Division or its agents before plugging was commenced? Yes

Name of Conservation Agent who supervised plugging of this well Ruel Durkee
Producing formation Viola Depth to top 4134 Bottom Total Depth of Well 4139 Feet
Show depth and thickness of all water, oil and gas formations.

OIL, GAS OR WATER RECORDS

CASING RECORD

Formation	Content	From	To	Size	Put In	Pulled Out
Viola	I.P. 724.5 oil & 15 water 6 hours flowing.	4134	4139	10 3/4" 7"	307' 4134	None 2631'

Describe in detail the manner in which the well was plugged, indicating where the mud fluid was placed and the method or methods used in introducing it into the hold. If cement or other plugs were used, state the character of same and depth placed, from _____ feet to _____ feet for each plug set.

Cemented bottom of hole. Mudded hole to bottom of surface pipe at 307' & ran 20 sax of cement. Filled surface pipe and capped with cement.

*Note: After this well was plugged on 1-17-46, gas channelled through the cement cap and orders were received from the State Plugged to drill out the plug. Unable to drill below 148'. Orders received from State Plugging to cease drilling & allow hole to remain open temporarily.

Moved in & rigged up pulling machine 1-27-47. Bailed hole down to bridge at 148'. Ran 5 sacks of Calseal and 10' of rock; capped with 10 sacks of cement. Mudded hole to 18' and capped with 14 sacks of cement and rock to top of surface pipe.

(If additional description is necessary, use BACK of this sheet)

Correspondence regarding this well should be addressed to Bethlehem Supply Company
Address Box 2171, Tulsa, Oklahoma

MADE - 6 1947
3-6-47

STATE OF Kansas, COUNTY OF Barton, ss.
J. L. Cleveland (employee of owner) or (owner or operator) of the above-described well,
being first duly sworn on oath, says: That I have knowledge of the facts, statements, and matters herein contained and the log of the above-described well as filed and that the same are true and correct. So help me God.

(Signature) J. L. Cleveland
Box 2171, Tulsa, Oklahoma (Address)

SUBSCRIBED AND SWORN to before me this 5th day of March, 19 47.

Betty Postlethwaite
Notary Public.

My commission expires January 24, 1949

