

STATE OF KANSAS
STATE CORPORATION COMMISSION

WELL PLUGGING RECORD

All Information Completely
Make Required Affidavit
Mail or Deliver Report to:
Conservation Division
State Corporation Commission
211 No. Broadway
Wichita, Kansas

Reno County, Sec. 16 Twp. 26S Rge. (E) 9 (W)

Location as "NE/CNW/SW" or footage from lines NE/4 SE/4 NE/4

Lease Owner Messman-Rinehart Oil Company

Lease Name Saylor-Jones Unit Well No. 1

Office Address 518 Petroleum Building, Wichita, Kansas

Character of Well (completed as Oil, Gas or Dry Hole) Dry Hole

Date well completed June 9, 1958 19 58

Application for plugging filed June 9 19 58

Application for plugging approved June 13 19 58


Plugging commenced June 9 19 58

Plugging completed June 9 19 58

Reason for abandonment of well or producing formation Dry Hole

If a producing well is abandoned, date of last production 19

Was permission obtained from the Conservation Division or its agents before plugging was commenced? yes

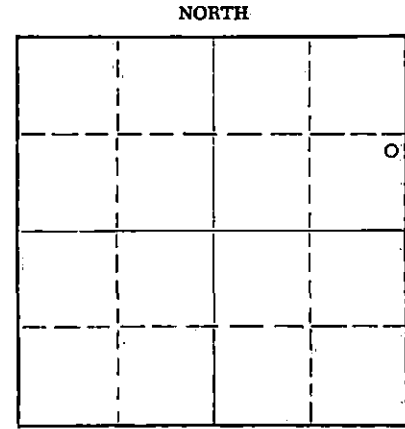

Locate well correctly on above
Section Plat

Name of Conservation Agent who supervised plugging of this well Fred W. Hampel

Producing formation _____ Depth to top _____ Bottom _____ Total Depth of Well 3976 Feet

Show depth and thickness of all water, oil and gas formations.

OIL, GAS OR WATER RECORDS

CASING RECORD

FORMATION	CONTENT	FROM	TO	SIZE	PUT IN	PULLED OUT
				8-5/8"	243'	none

Describe in detail the manner in which the well was plugged, indicating where the mud fluid was placed and the method or methods used in introducing it into the hole. If cement or other plugs were used, state the character of same and depth placed, from _____ feet to _____ feet for each plug set.

Heavy mud to 210 ft., set plug with 20 sx.
cement, heavy mud to 40 ft., set plug
with 10 sx. cement to surface.

(If additional description is necessary, use BACK of this sheet)

Name of Plugging Contractor Messman-Rinehart Oil Company

Address 518 Petroleum Building, Wichita, Kansas

STATE OF Kansas, COUNTY OF Sedgwick, ss.

J. A. Gilliland (employee of owner) or ~~operator~~ of the above-described well, being first duly sworn on oath, says: That I have knowledge of the facts, statements, and matters herein contained and the log of the above-described well as filed and that the same are true and correct. So help me God.

(Signature) *J. A. Gilliland*

518 Petroleum Building, Wichita, Kansas (Address)

SUBSCRIBED AND SWORN to before me this 19th day of June, 1958

RECEIVED
STATE CORPORATION COMMISSION
My commission expires STATE December 1, 1960

Barbara J. Scott
Notary Public.

JUN 21 1958

CONSERVATION DIVISION
Wichita, Kansas

PLUGGING
FILE SEC. 16 T. 26 R. 9W
BOOK PAGE 107 LINE 32

NO. 1 SAYLOR-JONES UNIT

Well Record

Location:	NE SE NE, Sec. 16-26S-9W Reno County, Kansas	Commenced:	May 31, 1958
Operator:	Messman-Rinehart Oil Company 518 Petroleum Building Wichita, Kansas	Completed:	June 9, 1958
Contractor:	Messman-Rinehart Oil Company 518 Petroleum Building Wichita, Kansas	Elevation:	1704' R/B
		Production:	D&A

Casing Record: 8-5/8" @ 243' w/175 sx: cem., 3 gal, 3 c.c.

* * * L O G * * *

Sand & Clay	30
Sand	170
Shale & Red Bed	243
Shale & Red Bed	680
Shale & Shells	1233
Anhydrite	1244
Shale	1256
Anhydrite	1289
Shale & Shells	1340
Shale & Lime	1525
Lime	1680
Lime & Shale	1895
Lime	2035
Lime & Shale	3455
Lime	3870
Lime & Shale	3924
Chert "Miss."	3936
Chert	3934
Lime & Chert	3976 R.T.D.

Sample Tops:

3367 - Brown Lime (-1663)
 3404 - Lansing (-1700)
 3922 - Mississippi Chert (-2218)
 3972 - Mississippi Lime (-2268)

The undersigned, MESSMAN-RINEHART OIL COMPANY, hereby certifies that the above log is a true and correct log of the formation encountered in drilling the above well as reflected by the Daily Drilling Reports.

MESSMAN-RINEHART OIL COMPANY


By: _____

J. A. Gilliland
 J. A. Gilliland

Subscribed and sworn to before me
 this 19th day of June, 1958.

Barbara J. Scott
 Barbara J. Scott, Notary Public

My Commission Expires: December 1, 1960

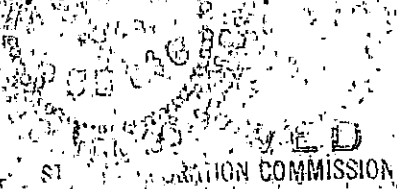

JUN 21 1958
 CONSERVATION DIVISION
 Wichita, Kansas

PLUGGING
 FILE SEC. 16 T. 26 R. 9W
 BOOK PAGE 107 LINE 32