


Give All Information Completely  
Make Required Affidavit  
File or Deliver Report to:  
Conservation Division  
State Corporation Commission  
800 Bitting Building  
Wichita, Kansas

WELL PLUGGING RECORD

NORTH

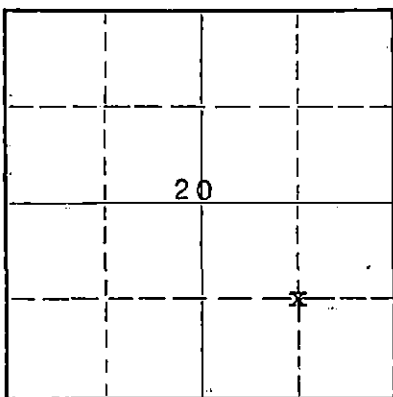

Locate well correctly on above Section Plat

Reno County, Sec. 20 Twp. 26 Rge. 9 ~~W~~ (W)  
Location as "NE/CNW/SW" or footage from lines C SE/4 NW/4  
Lease Owner Wood River Oil & Refining Co., Inc.  
Lease Name Victory Well No. 1  
Office Address 321 West Douglas, Wichita, Kansas  
Character of Well (completed as Oil, Gas or Dry Hole) Dry Hole  
Date well completed 7-25-1959  
Application for plugging filed 7-25-1959  
Application for plugging approved 7-26-1959  
Plugging commenced 7-26-1959  
Plugging completed 7-26-1959  
Reason for abandonment of well or producing formation Non-productible

If a producing well is abandoned, date of last production \_\_\_\_\_ 19\_\_\_\_  
Was permission obtained from the Conservation Division or its agents before plugging was commenced? Yes

Name of Conservation Agent who supervised plugging of this well Mr. Broadfoot, St. John, Kansas  
Producing formation Mississippian Depth to top 3932 Bottom 3960 Total Depth of Well 3960 Feet  
Show depth and thickness of all water, oil and gas formations.

OIL, GAS OR WATER RECORDS

CASING RECORD

| FORMATION     | CONTENT                                       | FROM | TO   | SIZE   | PUT IN | PULLED OUT |
|---------------|---|------|------|--------|--------|------------|
| Mississippian | 212' Salt Water<br>Small Show of Gas and Oil. | 3932 | 3960 | 8-5/8" | 433'   | None       |
|               |   |      |      |        |        |            |
|               |   |      |      |        |        |            |
|               |   |      |      |        |        |            |
|               |   |      |      |        |        |            |

Describe in detail the manner in which the well was plugged, indicating where the mud fluid was placed and the method or methods used in introducing it into the hole. If cement or other plugs were used, state the character of same and depth placed, from \_\_\_\_\_ feet to \_\_\_\_\_ feet for each plug set.  
Filled hole with mud to 300'. Set plug and cemented with 20 sacks thru drill pipe.  
Filled hole with mud to 35'. Set plug and 1/2 sack hulls. Cemented with 10 sacks cement to base of cellar.  
Completed 7-26-59

RECEIVED  
STATE CORPORATION COMMISSION  
AUG 3 1959 8-3-59  
CONSERVATION DIVISION  
Wichita, Kansas

(If additional description is necessary, use BACK of this sheet)  
Name of Plugging Contractor Garvey Drilling Company  
Address Great Bend, Kansas

STATE OF Kansas, COUNTY OF Sedgwick, ss.  
H.G. Rippeteau (employee of owner) or (owner or operator) of the above-described well, being first duly sworn on oath, says: That I have knowledge of the facts, statements, and matters herein contained and the log of the above-described well as filed and that the same are true and correct. So help me God.

(Signature) H.G. Rippeteau  
H. G. Rippeteau

SUBSCRIBED AND SWORN to before me this 30th day of July, 19 59

(Address)  
Pauline Gordon  
Notary Public.

My commission expires My commission expires Dec. 24, 1959



# WELL LOG

15-155-02030-0000

1766  
1024 1

COMPANY WOODRIVER OIL & REFINING COMPANY

SEC. 20 T. 26S R. 9W

FARM VICTORY

NO. 1

LOC. C-SE, NW


TOTAL DEPTH 3960'

COUNTY RENO CO., KANSAS

COMM. July 14, 1959

COMP. July 26, 1959

CONTRACTOR GARVEY DRILLING COMPANY

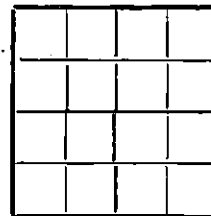

CASING 8 5/8" @ 433' W/275 sax.

ELEVATION 1697' DF

PRODUCTION D & A

FIGURES INDICATE BOTTOM OF FORMATIONS

|      |                 |
|------|-----------------|
| 105  | Sand & gravel   |
| 125  | Sand            |
| 434  | Red bed         |
| 1284 | Red bed & shale |
| 1795 | Lime & shale    |
| 1970 | Lime            |
| 2175 | Lime & shale    |
| 2958 | Shale & lime    |
| 3332 | Lime & shale    |
| 3458 | Shale & lime    |
| 3790 | Lime            |
| 3908 | Lime & shale    |
| 3940 | Lime & chert    |
| 3960 | Chert           |
| 3960 | T. D.           |

**RECEIVED**  
 OIL & GAS CORPORATION COMMISSION  
 OCT 13 1959  
 CONSERVATION DIVISION  
 Wichita, Kansas

State of KANSAS }  
 County of BARTON } ss:

I, VERNE A. MORRIS of GARVEY DRILLING COMPANY  
 upon oath state that the above and foregoing is a true and correct copy of the log of the #1 VICTORY well

Verne A. Morris  
 Subscribed and sworn to before me this 3rd day of September 1959

My Commission Expires: November 12, 1962

Stanbury  
 NOTARY PUBLIC