

15-155-02072-0000


STATE OF KANSAS
STATE CORPORATION COMMISSION

WELL PLUGGING RECORD

Give All Information Completely
Make Required Affidavit
Mail or Deliver Report to:
Conservation Division
State Corporation Commission
211 No. Broadway
Wichita, Kansas

Reno County. Sec. 10 Twp. 26S Rge. (E) 9 (W)
Location as "NE/CNW%SW%" or footage from lines App. E/2 SE/4 NE/4
Lease Owner Messman-Rinehart Oil Company
Lease Name Reece "B" Unit Well No. 2
Office Address 518 Petroleum Building, Wichita, Kansas
Character of Well (completed as Oil, Gas or Dry Hole) Dry Hole
Date well completed October 16 1958
Application for plugging filed October 28 1958
Application for plugging approved October 28 1958
Plugging commenced October 29 1958
Plugging completed November 1 1958
Reason for abandonment of well or producing formation Dry

NORTH

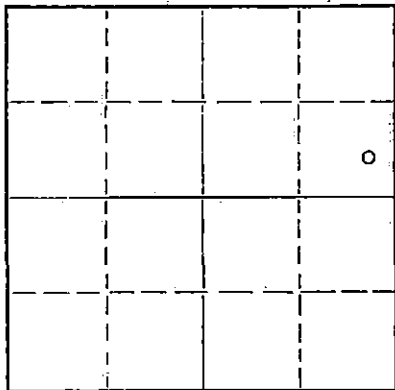

Locate well correctly on above
Section Plat

If a producing well is abandoned, date of last production 19
Was permission obtained from the Conservation Division or its agents before plugging was commenced? yes

Name of Conservation Agent who supervised plugging of this well Fred W. Hampel
Producing formation _____ Depth to top _____ Bottom _____ Total Depth of Well 3883 Feet
Show depth and thickness of all water, oil and gas formations.

OIL, GAS OR WATER RECORDS

CASING RECORD

FORMATION	CONTENT	FROM	TO	SIZE	PUT IN	PULLED OUT
				8-5/8"	325'	none
				4-1/2"	3877	3100'

Describe in detail the manner in which the well was plugged, indicating where the mud fluid was placed and the method or methods used in introducing it into the hole. If cement or other plugs were used, state the character of same and depth placed, from _____ feet to _____ feet for each plug set.

All perforations in bottom squeezed off.
Mudded hole to 270' and set 10' rock bridge
at 270' with 20 sx. cement. Mud to 40' and
set 10' rock bridge at 10' with 10 sx. cement
to base of cellar. Mud to surface.

(If additional description is necessary, use BACK of this sheet)

Name of Plugging Contractor Southwest Casing Pulling Co., Inc. - license No. 399
Address P. O. Box 364, Great Bend, Kansas

STATE OF Kansas, COUNTY OF Sedgwick, ss.
J. A. Gilliland (employee of owner) or (owner or operator) of the above-described well, being first duly sworn on oath, says: That I have knowledge of the facts, statements, and matters herein contained and the log of the above-described well as filed and that the same are true and correct. So help me God.

(Signature) *J. A. Gilliland*
518 Petroleum Building, Wichita, Kansas

SUBSCRIBED AND SWORN to before me this 18th day of November 1958

My commission expires December 1, 1960
Barbara J. Scott, Notary Public.

CONSERVATION DIVISION
Wichita, Kansas

PLUGGING
FILE SEC. 10 T. 26 R. 9W
BOOK PAGE 143 LINE 37

11-19-58

15-155-02672-000

COMPLETION DATA

NO. 2 REECE "B" UNIT

App. E/2 SE/4 NE/4
Section 10-26S-9W
Reno County, Kansas

- 10-10-58 - Moved in cable tools, drilled plug and cleaned out to bottom,
Drilled 3' to 3880', no shows
Made 250,000 cfg (esti.)
- 10-13-58 - Treated with 500 gal. mud acid, made about 160,000 cfg,
no increase in water
- 10-14-58 - Fraced with 3000# sand and 3500 gal. gel acid, recovered
all of load plus 10 bbls. water
Producing at the rate of 500,000 cfg, 970# csg., 480# tbg.,
and making 10 BWPH
- 10-15-58 - Blew well overnight - still making 10 BWPH
Preparing to abandon

MESSMAN-MINEHART OIL COMPANY

BY: 
Roger L. Messman

RLM/bjs

15-155-02072-6000

NO. 2 REECE 'B' UNIT

Well Record

Location: App. E/2 SE/4 NE/4 Section 10-26S-9W
 Reno County, Kansas

Commenced: September 29, 1958
 Completed: October 8, 1958
 (rotary)

Operator: Messman-Rinehart Oil Company
 518 Petroleum Building
 Wichita, Kansas

Elevation: 1680' K/B
 Production: D & A

Contractor: Messman-Rinehart Oil Company
 518 Petroleum Building
 Wichita, Kansas

Casing Record: 8-5/8" @ 325' w/200 sx. cem., 5 gal., 4 c.c.
 4-1/2" @ 3877' w/175 sx. cem., 2 gal.

*** LOG ***

Clay & Sand	70
Red Bed	325
Shale & Shells	800
Shale & Shells	1235
Anhydrite	1275
Shale & Lime	1400
Lime - Shale	2135
Shale & Lime	2425
Shale	2610
Shale & Lime	2760
Lime & Shale	3365
Lime	3550
Lime & Shale	3605
Lime	3704
Lime & Shale	3765
Lime & Shale	3875
Mississippi Chert	3880 R.T.D.

Sample Top:

3875' - Mississippi Chert (-2195)

The undersigned, MESSMAN-RINEHART OIL COMPANY, hereby certifies that the above log is a true and correct log of the formation encountered in drilling the above well as reflected by the Daily Drilling Reports.

MESSMAN-RINEHART OIL COMPANY

By: J. A. Gilliland
 J. A. Gilliland

Subscribed and sworn to before me
 this 28th day of October, 1958.

Barbara J. Scott
 Barbara J. Scott, Notary Public

My Commission Expires: December 1, 1960

PLUGGING
 FILE SEC. 10 T. 26 R. 9W
 BOOK PAGE 143 LINE 37

CONSERVATION DIVISION
 Wichita, Kansas