

STATE OF KANSAS
STATE CORPORATION COMMISSION


WELL PLUGGING RECORD

Give All Information Completely
Make Required Affidavit
Mail or Deliver Report to:
Conservation Division
State Corporation Commission
800 Bittling Building
Wichita, Kansas

OR
FORMATION PLUGGING RECORD

Strike out upper line
when reporting plug-
ging off formations.

NORTH

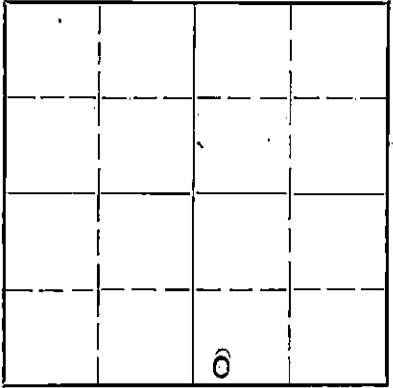

Locate well correctly on above
Section Plat

RENO County. Sec. 10 Twp. 26 Rge. (E) 9 (W)
Location as "NE 1/4 NW 1/4 SW 1/4" or footage from lines SW 1/2 SW 1/2 SE 1/2 330' SL: 330' WL
Lease Owner SHELL OIL CO. INC.
Lease Name V. P. LEE Well No. 3
Office Address BOX 744 GREAT BEND, KANSAS
Character of Well (completed as Oil, Gas or Dry Hole) OIL WELL
Date well completed MAY 16 19 37
Application for plugging filed FEBRUARY 16 19 44
Application for plugging approved FEBRUARY 18 19 44
Plugging commenced MAY 8 19 44
Plugging completed MAY 13 19 44
Reason for abandonment of well or producing formation DEPLETION OF OIL

If a producing well is abandoned, date of last production FEBRUARY 14 19 42
Was permission obtained from the Conservation Division or its agents before plugging was com-
menced? YES

Name of Conservation Agent who supervised plugging of this well RUEL DURKEE
Producing formation VIOLA LIMESTONE Depth to top 41 36 Bottom Total Depth of Well 41 39 Feet
Show depth and thickness of all water, oil and gas formations.


OIL, GAS OR WATER RECORDS

CASING RECORD

Formation	Content	From	To	Size	Put In	Pulled Out
VIOLA LIMESTONE	2,666 oil, 0 water. (Initial Pot'l 5-16-37)	41 36	41 39	10 1/2" 7"	31 4' 41 36'	NONE 26 21'

Describe in detail the manner in which the well was plugged, indicating where the mud fluid was placed and the method or methods used in introducing it into the hold. If cement or other plugs were used, state the character of same and depth placed, from feet to feet for each plug set.

Mudded hole to 315'. Set rock bridge from 315 to 300'. Dumped 15 sacks cement. Mudded to 5' and capped into cellar with 5 sacks cement.

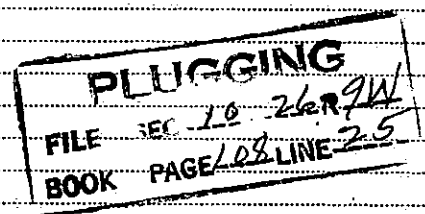

(If additional description is necessary, use BACK of this sheet)

Correspondence regarding this well should be addressed to SHELL OIL CO. INC.
Address W. M. Gholson Box 744 Great Bend, Kansas


STATE OF KANSAS COUNTY OF BARTON, ss.
W. M. GHOLSON (employee of owner) or owner or operator of the above-described well,

being first duly sworn on oath, says: That I have knowledge of the facts, statements, and matters herein contained and the log of the above-described well as filed and that the same are true and correct. So help me God.

(Signature)

SUBSCRIBED AND SWORN to before me this 22nd day of May

My commission expires Jan 24, 1945

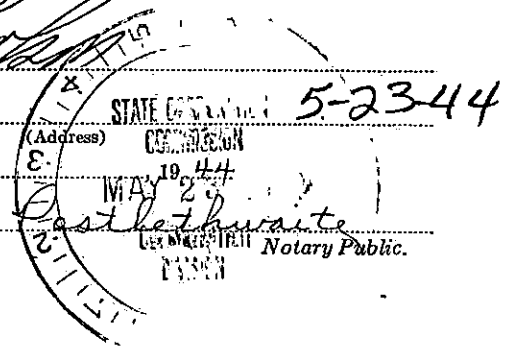


15-155-02465-0000

MATERIAL REPORT AND PLUGGING RECORD

Mail To: STATE CORPORATION COMMISSION
Conservation Division
800 Biting Building
Wichita, Kansas

NOTICE: All questions on this form must be answered.

Company Operating SHELL OIL CO. INC.
Office Address BOX 744 GREAT BEND, KANSAS

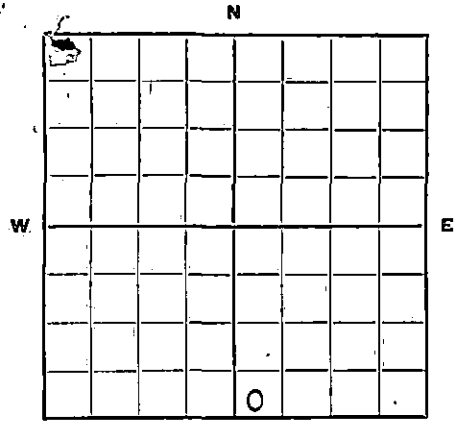

Locate well ^S correctly.

County RENO Sec. 10 Twp. 26 S Rge. 9 W
Farm Name V. P. LEE Well No. 3 Field _____
Well Location SW SW SE
Name of Producing Sand VIOLA LIMESTONE Total Depth 4139
Commenced Plugging 5-8-44 Finished 5-13-44

DAILY AVERAGE PRODUCTION:

Initial Production: Oil 2,666 Gas -- Water 0
Production when Plugged: Oil 3 Gas 0 Water 920
(2-14-42)


Estimated Total Remaining Reserves Attributable to Well at Time Abandoned _____

INFORMATION ON MATERIALS RECLAIMED FROM WELL CASING, TUBING AND ROD DATA

Description	Size	Recovered		Junk		Reusable		Disposition Made Or To Be Made Of Usable Material
		Ft.	Tons	Ft.	Tons	Ft.	Tons	
24# csg.	7"	2621	31			2621	31	Store Stock
9.3#	3"	4300	20			4300	20	Store Stock
Sucker rods	7/8	4300	4 1/2					

SURFACE EQUIPMENT

Quantity	Description	*Condition	Est. Tons	Disposition Made Or To Be Made Of Reclaimed Material
1	OCS front	Usable	10	Store Stock
1	Csg. & Tbg. Head	Usable	1/4	Store Stock
1	Electric Motor	Usable	1	Store Stock
	Misc. Surface Equip.	Junk	1	Junk

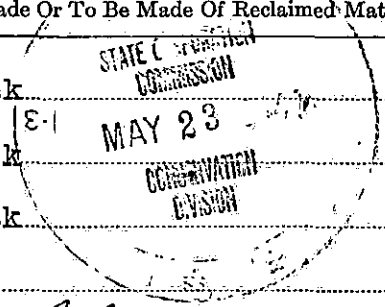

* Usable, Usable with minor repairs, or junk.
Date: May 22, 1944 Signed: [Signature] (For Operating Co.—Title)

(See note on reverse side) 19-8756 3-43-5M

PLUGGING
FILE EL 10 26R 9K
BOOK PAGE 108 LINE 25

It is very important that all questions on this form be answered, as this Department has been asked by the Petroleum Administration for War to supply data on well abandonments undertaken during the war.

This information is very essential in aiding the war effort; therefore, this Department is requiring this report to be mailed within 5 days after the abandonment of your well.

19-6756