


STATE OF KANSAS
STATE CORPORATION COMMISSION

Give All Information Completely
Make Required Affidavit
Mail or Deliver Report to:
Conservation Division
State Corporation Commission
800 Bittling Building
Wichita, Kansas

WELL PLUGGING RECORD
OR
FORMATION PLUGGING RECORD

Strike out upper line
when reporting plug-
ging of formations.

26S

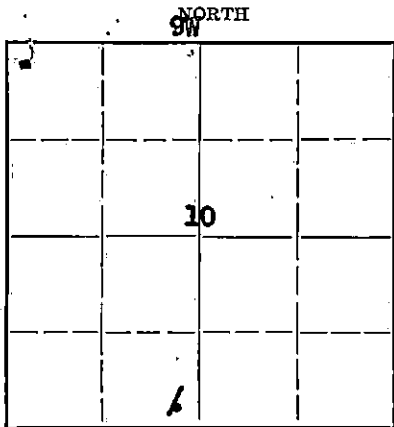

Locate well correctly on above
Section Plat

Reno County, Sec. 10, Twp 26S, Rge. 9 (E) W (W)
Location as "NE 1/4 NW 1/4 SW 1/4" or footage from lines Center SE, SE, SW
Lease Owner Gulf Oil Corporation
Lease Name F. L. Reeca Well No. 1
Office Address Box 661, Tulsa, Oklahoma
Character of Well (completed as Oil, Gas or Dry Hole) oil
Date well completed 4-2 1937
Application for plugging filed 5-13 1939
Application for plugging approved 5-13 1939
Plugging commenced 5-17 19 39
Plugging completed 5-31 19 39
Reason for abandonment of well or producing formation Well producing 98.5%
water. No longer profitable to operate.
If a producing well is abandoned, date of last production 5-10 19 39
Was permission obtained from the Conservation Division or its agents before plugging was com-
menced? Yes

Name of Conservation Agent who supervised plugging of this well Ruel Durkee
Producing formation Viola Lime Depth to top 4140 Bottom 4143 Total Depth of Well 4143 Feet
Show depth and thickness of all water, oil and gas formations.

OIL, GAS OR WATER RECORDS

CASING RECORD

Formation	Content	From	To	Size	Put In	Pulled Out
Viola Lime	oil & water	4140	4143	15 1/2 7"	370 4140	none 2800

Describe in detail the manner in which the well was plugged, indicating where the mud fluid was placed and the method or methods used in introducing it into the hold. If cement or other plugs were used, state the character of same and depth placed, from.....feet to.....feet for each plug set.

Dumped 6 sacks cement 4143 to 4142'. Filled hole with heavy mud from 4142 to 385.
Crushed rock from 385 to 380'. Cemented with 22 sacks cement from 380 to 360'.
Filled with heavy mud from 360 to 10'. Cemented with 14 sacks cement from 10' to
surface and base of cellar.

FILE 10 26 9W
62 34

(If additional description is necessary, use BACK of this sheet)

Correspondence regarding this well should be addressed to S. G. Sanderson
Address Box 661, Tulsa, Oklahoma

STATE OF Kansas, COUNTY OF Rice, ss.

(employee of owner) or (owner or operator) of the above-described well,
being first duly sworn on oath, says: That I have knowledge of the facts, statements, and matters herein contained and the log of the above-
described well as filed and that the same are true and correct. So help me God.

(Signature)

Charles Renter

Box 544, Chase, Kansas
(Address)

SUBSCRIBED AND SWORN TO before me this 22nd day of

March

Virgil S. Stevenson

Notary Public

My commission expires

May 18, 1946



5-26-43