


Give All Information Completely
Make Required Affidavit
Mail or Deliver Report to:
Conservation Division
State Corporation Commission
800 Biting Building
Wichita, Kansas

15-51-10949-0000

WELL PLUGGING RECORD

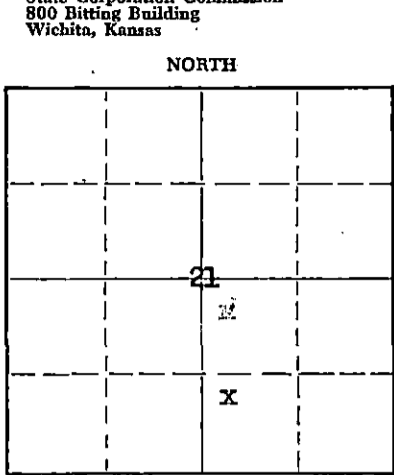

Locate well correctly on above
Section Plat

Pratt County, Sec. 21 Twp. 26S Rge. 15 (W)
Location as "NE/CNW&SW" or footage from lines NW/4 SW/4 SE/4
Lease Owner Monsanto Chemical Company
Lease Name Curtis Well No. 1
Office Address P. O. Box 639, Pratt, Kansas
Character of Well (completed as Oil, Gas or Dry Hole) Dry hole
Date well completed October 12 19 55
Application for plugging filed October 15 19 55
Application for plugging approved October 17 19 55
Plugging commenced October 28 19 55
Plugging completed October 29 19 55
Reason for abandonment of well or producing formation Dry hole

If a producing well is abandoned, date of last production _____ 19____
Was permission obtained from the Conservation Division or its agents before plugging was commenced? Yes

Name of Conservation Agent who supervised plugging of this well Mr. M. A. Rives
Producing formation _____ Depth to top _____ Bottom _____ Total Depth of Well 4260 Feet
Show depth and thickness of all water, oil and gas formations.

OIL, GAS OR WATER RECORDS

CASING RECORD

| FORMATION | CONTENT | FROM | TO | SIZE | PUT IN | PULLED OUT |
|-----------|---------|------|----|--------|--------|------------|
| | | | | 8-5/8" | 1014' | None |
| | | | | 5-1/2" | 4255' | 3020' |
| | | | | | | |
| | | | | | | |
| | | | | | | |
| | | | | | | |
| | | | | | | |

Describe in detail the manner in which the well was plugged, indicating where the mud fluid was placed and the method or methods used in introducing it into the hole. If cement or other plugs were used, state the character of same and depth placed, from _____ feet to _____ feet for each plug set.

Plugged back with sand from 3932' to 3900', 5 sacks of cement on top of sand. Heavy Mud to 300'. Set 10' rock plug @ 300' with 20 sacks of cement on top of plug. Heavy mud from 230' to 35' and set rock plug at 35' with 10 sacks of cement on top of plug. cement to base of cellar.

RECEIVED
STATE CORPORATION COMMISSION

NOV - 2 1955

CONSERVATION DIVISION
Wichita, Kansas

11-2-1955

(If additional description is necessary, use BACK of this sheet)
Name of Plugging Contractor West Supply Company
Address Chase, Kansas

STATE OF KANSAS, COUNTY OF PRATT, ss.
J. B. Gibbs (employee of owner) or (~~owner or operator~~) of the above-described

well, being first duly sworn on oath, says: That I have knowledge of the facts, statements, and matters herein contained and the log of the above-described well as filed and that the same are true and correct. So help me God.

(Signature) [Signature]
P. O. Box 639, Pratt, Kansas
(Address)

SUBSCRIBED AND SWORN TO before me this 31st day of October, 1955

Mule Z. Combs
Notary Public.

My commission expires September 19, 1959

PLUGGING
FILE SEC 21 T 26 R 6W
BOOK PAGE 7 LINE 26

WELL LOG

15-151-10949-0000

COMPANY LION OIL COMPANY

SECT 21 T. 26 R. 15

FARM Curtis NO. 1


LOC. NW SW SE

TOTAL DEPTH 4260'

COUNTY Pratt

COMM. September 20, 1955 COMP. October 5, 1955

CONTRACTOR GARVEY DRILLING COMPANY

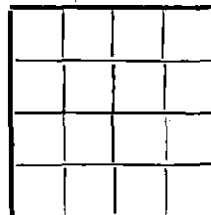

CASING 8-5/8" @ 1014' w/700 sacks
5-1/2" @ 4250' w/200 sacks

ELEVATION

PRODUCTION

FIGURES INDICATE BOTTOM OF FORMATIONS

| | |
|------|-----------------------|
| 40 | Surface Soil & Sand |
| 250 | Sand & Shale |
| 705 | Shale |
| 880 | Red Bed, Shale & Sand |
| 1007 | Sand & Red Bed |
| 1025 | Anhydrite |
| 1530 | Red Bed & Shale |
| 1795 | Shale & Salt |
| 2100 | Shale & Shells |
| 2425 | Lime & Shale |
| 2505 | Lime |
| 2840 | Lime & Shale |
| 2925 | Lime (Broken) |
| 3080 | Shale |
| 3930 | Lime & Shale |
| 4260 | Lime |
| 4260 | T.D. |

RECEIVED
THE CONSERVATION COMMISSION
OCT 22 1955
CONSERVATION DIVISION
Wichita, Kansas

State of KANSAS
County of SEDGWICK

PLUGGING
FILE SEC 21 T 26 R 15 W
BOOK PAGE 3 LINE 36

I, Robert F. White of GARVEY DRILLING COMPANY

do hereby state that the above and foregoing is a true and correct copy of the log of the #1 Curtis well

Robert F. White
Attorney In Fact

Subscribed and sworn to before me this 13th day of October 1955

My Commission Expires: August 8, 1959

Gloria Morrison
NOTARY PUBLIC