


WELL PLUGGING RECORD

Give All Information Completely  
Make Required Affidavit  
Mail or Deliver Report to:  
Conservation Division  
State Corporation Commission  
211 No. Broadway  
Wichita, Kansas

STAFFORD County. Sec. 17 Twp. 25s Rge. 14w (W) (W)

NORTH

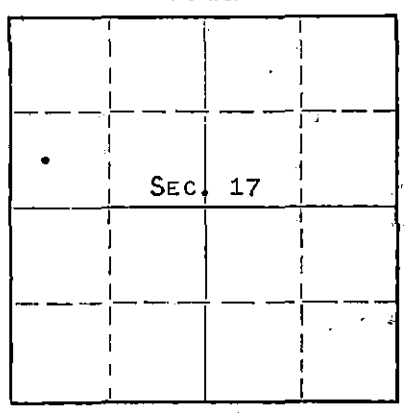

Locate well correctly on above  
Section Plat

Location as "NE/CNW/SW" or footage from lines APP. C SW NW  
Lease Owner PETROLEUM, INC.,  
Lease Name BEAR "B" Well No. 1  
Office Address ROUTE 2, GREAT BEND, KANSAS  
Character of Well (completed as Oil, Gas or Dry Hole) OIL  
Date well completed SEPTEMBER 23, 1961  
Application for plugging filed JUNE 25, 1963  
Application for plugging approved JULY 16, 1963  
Plugging commenced JULY 17, 1963  
Plugging completed JULY 22, 1963  
Reason for abandonment of well or producing formation DEPLETION OF  
PRODUCIBLE FORMATIONS

If a producing well is abandoned, date of last production MAY 1, 1963  
Was permission obtained from the Conservation Division or its agents before plugging was commenced? YES

Name of Conservation Agent who supervised plugging of this well ARCHIE ELVING  
Producing formation MISSISSIPPI Depth to top 4160 Bottom - - Total Depth of Well 4285 Feet  
Show depth and thickness of all water, oil and gas formations.

OIL, GAS OR WATER RECORDS

CASING RECORD

FORMATION	CONTENT	FROM	TO	SIZE	PUT IN	PULLED OUT
MISSISSIPPI	WATER & SMALL AMOUNT OF OIL	4188	4202	8-5/8" 5-1/2"	293' 4282'	NONE 3475'

Describe in detail the manner in which the well was plugged, indicating where the mud fluid was placed and the method or methods used in introducing it into the hole. If cement or other plugs were used, state the character of same and depth placed, from feet to feet for each plug set.

PRESENT T.D. 4254'  
FILLED HOLE WITH CRUSHED ROCK FROM 4254' TO 4129', PLACED 5 SACKS CEMENT ONTO CRUSHED ROCK. GLOBE OILWELL CEMENTING COMPANY SQUEEZED WITH 10 SACKS JELL AND 80 SACKS CEMENT

RECEIVED  
STATE CORPORATION COMMISSION

AUG 2 1963

CONSERVATION DIVISION  
Wichita, Kansas

(If additional description is necessary, use BACK of this sheet)  
Name of Plugging Contractor SOUTHWEST CASING PULLING COMPANY, INC.  
Address Box 364, GREAT BEND, KANSAS

STATE OF KANSAS, COUNTY OF BARTON, ss.  
MONTE CHADD (employee of owner) or (owner/contractor) of the above-described

well, being first duly sworn on oath, says: That I have knowledge of the facts, statements, and matters herein contained and the log of the above-described well as filed and that the same are true and correct. So help me God.

(Signature) MONTE CHADD, DIST. PROD. FOREMAN  
ROUTE 2, GREAT BEND, KANSAS  
(Address)

SUBSCRIBED AND SWORN TO before me this 1st day of AUGUST, 1963

My commission expires APRIL 14, 1967

Archie J. Orville  
Notary Public.

# WELL LOG

COMPANY PETROLEUM, INCORPORATED

SEC. 17 T. 25S R. 14W

FARM BEAR "B" NO. 1

LOC. C-SW, SW


TOTAL DEPTH 4285'

COUNTY STAFFORD CO., KANSAS

COMM. June 9, 1961 COMP. June 19, 1961

CONTRACTOR GARVEY DRILLING COMPANY

CASING 8-5/8" @ 293' w/225 sax.  
5 1/2" @ 4282' w/125 sax.

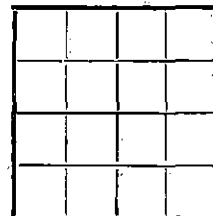

ELEVATION 1987' DF

PRODUCTION Mississippi

FIGURES INDICATE BOTTOM OF FORMATIONS

210	Surface sand & gravel
293	Shale & red bed
924	Red bed & shells
938	Anhydrite
1900	Shale
1955	Lime & shale
2350	Lime
2400	Lime & shale
3010	Shale w/lime streaks
3488	Lime & shale
3560	Lime
3695	Lime & shale
4050	Lime
4170	Cherty lime
4235	Lime
4285	Lime & chert
4285	T. D.

**RECEIVED**  
STATE CORPORATION COMMISSION

AUG 2 1963

CONSERVATION DIVISION  
Wichita, Kansas

State of KANSAS }  
County of BARTON } ss

I, VERNE A. MORRIS of GARVEY DRILLING COMPANY

upon oath state the above and foregoing is a true and correct copy of the log of the #1 BEAR "B" well.

*Verne A. Morris*

Subscribed and sworn to before me this 6th day of July 19 61

My Commission Expires: April 14, 1963

*Arthur J. Miles*  
NOTARY PUBLIC