


Give All Information Completely  
Make Required Affidavit  
Mail or Deliver Report to:  
Conservation Division  
State Corporation Commission  
211 No. Broadway  
Wichita, Kansas

WELL PLUGGING RECORD

NORTH

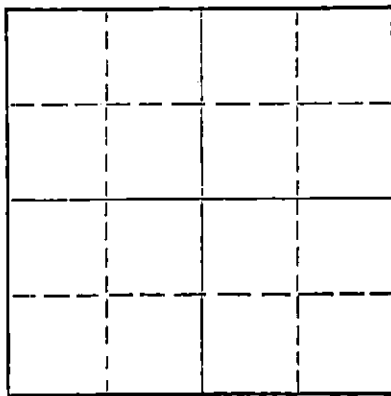

Locate well correctly on above  
Section Plat

Stafford County, Sec. 14 Twp 25S Rge. 14W (X) (W)  
Location as "NE/CNWSW" or footage from lines NW SW SE  
Lease Owner Kansas Exploration  
Lease Name Bath Well No. 1  
Office Address 232 Bonnie Brae, Wichita, Kansas  
Character of Well (completed as Oil, Gas or Dry Hole) Dry Hole  
Date well completed 3-26-65 19  
Application for plugging filed 3-26-65 19  
Application for plugging approved 3-26-65 19  
Plugging commenced 3-26-65 19  
Plugging completed 3-26-65 19  
Reason for abandonment of well or producing formation Dry Hole

If a producing well is abandoned, date of last production 19  
Was permission obtained from the Conservation Division or its agents before plugging was commenced? yes

Name of Conservation Agent who supervised plugging of this well Archie Elving, Pratt, Kansas  
Producing formation Depth to top Bottom Total Depth of Well 4114 Feet  
Show depth and thickness of all water, oil and gas formations.

OIL, GAS OR WATER RECORDS

CASING RECORD

FORMATION	CONTENT	FROM	TO	SIZE	PUT IN	PULLED OUT
				8 5/8"	260'	none

Describe in detail the manner in which the well was plugged, indicating where the mud fluid was placed and the method or methods used in introducing it into the hole. If cement or other plugs were used, state the character of same and depth placed, from feet to feet for each plug set.

Heavy Mud to 240' Plug 1/4 sk. hulls 25 sks. cement through drill pipe  
Mud to 40' 1/3 sk. hulls Plug 10 sks. cement

RECEIVED  
STATE CORPORATION COMMISSION

MAR 30 1965

CONSERVATION DIVISION  
WICHITA, KANSAS

(If additional description is necessary, use BACK of this sheet)  
Name of Plugging Contractor Leben Drilling, Inc.  
Address Box 486, Great Bend, Kansas 67530

3-30-1965

STATE OF KANSAS, COUNTY OF BARTON, ss.  
Leslie Kite (employee of owner) or (owner or operator) of the above-described well, being first duly sworn on oath, says: That I have knowledge of the facts, statements, and matters herein contained and the log of the above-described well as filed and that the same are true and correct. So help me God.

(Signature) Leslie Kite  
Box 486, Great Bend, Kansas (Address)

SUBSCRIBED AND SWORN TO before me this 29th day of March, 19 65

My commission expires April 1, 1967

Alandas Nicholas  
Notary Public.

DRILLER'S LOG

COMPANY: Kansas Exploration  
 CONTRACTOR: LEBEN DRILLING, INC.  
 FARM: BATH #1  
 LOCATION: NW SW SE Sec. 14-25S-14W  
 STAFFORD COUNTY, KANSAS  
 COMMENCED: 3-19-65  
 COMPLETED: 3-26-65

0	200	Sand
200	260	Shale
260	525	Redbed
525	903	Shale
903	920	Anhydrite
920	1545	Shale
1545	1900	Shale & Lime
1900	2320	Lime
2320	2960	Shale & Lime Streaks
2960	3185	Shale
3185	3450	Shale & Lime
3450	3560	Lime & Shale
3560	3750	Shale & Lime
3750	4114	Lime
	<u>4114</u>	<u>RTD - D &amp; A.</u>

RECEIVED  
 STATE CORPORATION COMMISSION  
 MAR 30 1965  
 CONSERVATION DIVISION  
 Wichita, Kansas

Set 8 5/8" used surface casing @ 260' cemented with 250 sacks 60-40  
 Posmix Sunset 2% Gel.

I, Leslie Kite, do hereby certify that the above and foregoing is a true and correct copy of the log of the Bath #1 well, located NW SW SE of Section 14, Township 25 South, Range 14 West, Stafford County, Kansas, as reflected by the files of Leben Drilling, Inc.

*Leslie Kite*  
 \_\_\_\_\_  
 Leslie Kite

STATE OF KANSAS )  
 ) SS  
 COUNTY OF BARTON )

Subscribed and sworn to before me, a Notary Public, in and for Barton County, Kansas, this 29th day of March, 1965.

*Ulanda Nichols*  
 \_\_\_\_\_  
 Ulanda Nichols

My Commission Expires: April 1, 1967