


STATE OF KANSAS
STATE CORPORATION COMMISSION

WELL PLUGGING RECORD

Give All Information Completely
Make Required Affidavit
Mail or Deliver Report to:
Conservation Division
State Corporation Commission
211 No. Broadway
Wichita, Kansas

Stafford County. Sec. 14 Twp. 25 Rge. 14 (W) W(W)
Location as "NE/CNW&SW&" or footage from lines NE NE SE
Lease Owner Petroleum, Inc.
Lease Name Tanner Well No. 1
Office Address Route 2, Great Bend, Kansas
Character of Well (completed as Oil, Gas or Dry Hole) Dry hole
Date well completed April 14 1957
Application for plugging filed April 14 1957
Application for plugging approved April 14 1957
Plugging commenced April 14 1957
Plugging completed April 14 1957
Reason for abandonment of well or producing formation No Producing zones

NORTH

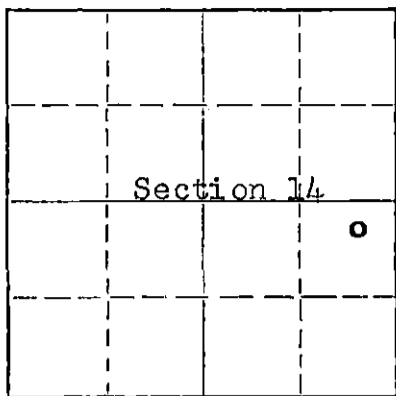

Locate well correctly on above
Section Plat

If a producing well is abandoned, date of last production None 19
Was permission obtained from the Conservation Division or its agents before plugging was commenced? Yes

Name of Conservation Agent who supervised plugging of this well R.M. Brundage Hoisington, Kansas
Producing formation --- Depth to top -- Bottom -- Total Depth of Well 4330 Feet
Show depth and thickness of all water, oil and gas formations.

OIL, GAS OR WATER RECORDS

CASING RECORD

FORMATION	CONTENT	FROM	TO	SIZE	PUT IN	PULLED OUT
				8 5/8"	327'	None

Describe in detail the manner in which the well was plugged, indicating where the mud fluid was placed and the method or methods used in introducing it into the hole. If cement or other plugs were used, state the character of same and depth placed, from _____ feet to _____ feet for each plug set.

Mud up with heavy mud to 325' pushed down 1/3 sack hulls to 325' followed by wooden plug. Placed 20 sacks cement through drill pipe on to plug. Mud up to 35' and placed 1/3 sack hulls at 35' followed by wooden plug and 10 sacks cement to base of well cellar.

(If additional description is necessary, use BACK of this sheet)

Name of Plugging Contractor Garvey Drilling Co.
Address Route 2, Great Bend, Kansas

STATE OF Kansas, COUNTY OF Barton, ss.
Don Searle (employee of owner) or (~~owner or operator~~) of the above-described well, being first duly sworn on oath, says: That I have knowledge of the facts, statements, and matters herein contained and the log of the above-described well as filed and that the same are true and correct. So help me God.

(Signature) Don Searle
Route 2, Great Bend, Kansas
(Address)

SUBSCRIBED AND SWORN to before me this 24th day of April 1957

My commission expires July 11, 1960

[Signature]
Notary Public.

RECEIVED
STATE CORPORATION COMMISSION

4-25-1957
APR 25 1957

CONSERVATION DIVISION FILE SEC. 14 T. 25 R. 14 W
Wichita, Kansas

PLUGGING
BOOK PAGE 6 LINE 13

WELL LOG

COMPANY PETROLEUM, INCORPORATED

SEC. 14 T. 25S. R. 14W

FARM TANNER

NO. 1

LOC. NE, NE, SE


TOTAL DEPTH 4330'

COUNTY Stafford Co., Kansas

COMM. March 29, 1957

COMP. April 14, 1957

CONTRACTOR GARVEY DRILLING COMPANY

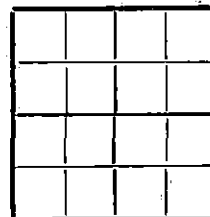

CASING 8 5/8" @ 327' W/225 sax.

ELEVATION 1964' DF

PRODUCTION D & A

FIGURES INDICATE BOTTOM OF FORMATIONS

50	Sand	Anhydrite	870'
270	Shale & clay	Heebner	3526
870	Red bed	Toronto	3542
890	Anhydrite	Douglas	3566
1190	Red bed & shale	B. Lime	3679
1700	Shale	Lansing	3707
3470	Lime & shale	Arbuckle	4301
3534	Lime		
3797	Lime & shale		
4004	Lime		
4072	Lime & chert		
4100	Lime & shale		
4140	Chert & shale		
4220	Shale		
4238	Chert		
4330	Lime		
4330	T. D.		

PLUGGING
FILE SEC. 14 T. 25 R. 14W
BOOK PAGE 6 LINE 17

State of KANSAS)
County of BARTON) ss:

I, Verne A. Morris of Garvey Drilling Co.
Wichita, Kansas

upon oath state that the above and foregoing is a true and correct copy of the log of the #1 Tanner well

Subscribed and sworn to before me this 23rd day of April 19 57

My Commission Expires: July 11, 1960

Verne A. Morris
Ed J. Brown
NOTARY PUBLIC

RECEIVED
STATE CORPORATION COMMISSION

APR 25 1957

CONSERVATION DIVISION
Wichita, Kansas