

Give All Information Completely  
Make Required Affidavit  
Mail or Deliver Report to:  
Conservation Division  
State Corporation Commission  
211 No. Broadway  
Wichita, Kansas

WELL PLUGGING RECORD

Stafford County. Sec. 14 Twp. 25 Rge. (E) 14 (W)

Location as "NE/CNW%SW%" or footage from lines NE NE SE

Lease Owner Thomas W. Clay

Lease Name Tanner Well No. 1

Office Address Suite 1010, Peoples National Bank Bldg., Tyler, Texas

Character of Well (completed as Oil, Gas or Dry Hole) oil

Date well completed \_\_\_\_\_ 19\_\_\_\_

Application for plugging filed January 27 19 64

Application for plugging approved \_\_\_\_\_ 19\_\_\_\_


Plugging commenced January 28 19 64

Plugging completed February 2 19 64

Reason for abandonment of well or producing formation depleted

If a producing well is abandoned, date of last production \_\_\_\_\_ 19\_\_\_\_

Was permission obtained from the Conservation Division or its agents before plugging was commenced? yes

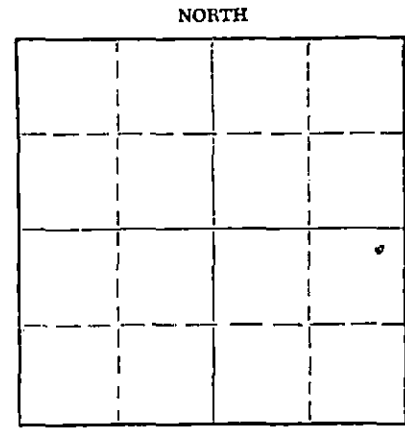

Locate well correctly on above Section Plat

Name of Conservation Agent who supervised plugging of this well W. L. Lackamp

Producing formation \_\_\_\_\_ Depth to top \_\_\_\_\_ Bottom \_\_\_\_\_ Total Depth of Well 4330 Feet

Show depth and thickness of all water, oil and gas formations.

OIL, GAS OR WATER RECORDS

CASING RECORD

FORMATION	CONTENT	FROM	TO	SIZE	PUT IN	PULLED OUT
		0	327	8 5/8"	327	none
		0	4325	5 1/2"	4325	2015.97

Describe in detail the manner in which the well was plugged, indicating where the mud fluid was placed and the method or methods used in introducing it into the hole. If cement or other plugs were used, state the character of same and depth placed, from \_\_\_\_\_ feet to \_\_\_\_\_ feet for each plug set.

Push plug to 3850', sand back to 3840' and dump 5 sacks of cement.

Set bridge at 275', set 10' rock bridge and dump 2 sacks of calseal.

Run 240' of 2" tubing and pump in 25 sacks of cement. Fill with mud to 40', set 10' rock bridge and cap with 10 sacks of cement.

RECEIVED  
STATE CORPORATION COMMISSION

FEB 11 1964

Name of Plugging Contractor Pipe Pullers, Inc. (If additional description is necessary, use BACK of this sheet)  
Address Box 486, Ellinwood, Kansas CONSERVATION DIVISION  
Wichita, Kansas

STATE OF Kansas, COUNTY OF Barton, ss.  
Dean Wells (employee of owner) or (~~owner or operator~~) of the above-described well, being first duly sworn on oath, says: That I have knowledge of the facts, statements, and matters herein contained and the log of the above-described well as filed and that the same are true and correct. So help me God.

(Signature) Dean Wells  
Ellinwood, Kansas  
(Address)

SUBSCRIBED AND SWORN TO before me this 3rd day of February, 19 64

My commission expires July 7, 1964

Notary Public.

WELL LOG BUREAU—KANSAS GEOLOGICAL SOCIETY  
508 East Murdock, Wichita, Kansas

COPY

Company- PETROLEUM, INCORPORATED  
Farm- Tanner No. 1

SEC. 14 T. 25 R. 11W  
NE NE SE

Total Depth. 4330  
Comm. 3-29-57 Comp. 4-14-57  
Shot or Treated.  
Contractor. Garvey Drilling Company  
Issued. 5-25-57

County Stafford  
KANSAS



Elevation. 1964' DF

CASING:

8 5/8" @ 327' w/225 sx cem.

Production. Dry

Figures indicate Bottom of Formations.

sand	50
shale & clay	270
red bed	870
Anhydrite	890
red bed & shale	1190
shale	1700
lime & shale	3470
lime	3534
lime & shale	3797
lime	4004
lime & chert	4072
lime & shale	4100
chert & shale	4140
shale	4220
chert	4238
lime	4330

Total Depth

TOPS	
Anhydrite	870
Heebner	3526
Toronto	3542
Douglas	3566
Brown Lime	3679
Lansing	3707
Marmaton (Scout)	4041
Mississippi Chert (Scout)	4082
Kinderhook (Scout)	4121
Viola (Scout)	4198
Simpson Shale (Scout)	4249
Simpson Sand (Scout)	4267
Arbuckle	4301