

STATE CORPORATION COMMISSION OF KANSAS
OIL & GAS CONSERVATION DIVISION
WELL COMPLETION OR RECOMPLETION FORM
ACO-1 WELL HISTORY
DESCRIPTION OF WELL AND LEASE

Operator: License # 5340
Name Energy Three, Inc.
Address P.O. Box 1505
Great Bend
City/State/Zip Kansas 67530-1505

Purchaser Koch Oil/Panhandle Eastern

Operator Contact Person Paul Gunzelman
Phone (316) 264-6366

Contractor: License # Mull-5144
Name Mull Drilling Company, Inc.

Wellsite Geologist C.R. Sullivan
Phone

Designate Type of Completion
New Well Re-Entry Workover

X Oil SWD Temp Abd
Gas Inj Delayed Comp.
Dry Other (Core, Water Supply etc.)

If ON/O: old well info as follows:
Operator
Well Name
Comp. Date Old Total Depth

WELL HISTORY

Drilling Method:
X Mud Rotary Air Rotary Cable
3/14/58 3/31/58 4/15/58
Spud Date Date Reached TO Completion Date
4685' 4090'
Total Depth P8TD

Amount of Surface Pipe Set and Cemented at 1029 feet
Multiple Stage Cementing Collar Used? Yes X No
If yes, show depth set. feet
If alternate 2 completion, cement circulated
from. feet depth to. w/ SX amt
Cement Company Name
Invoice #

API NO. 15-151-00054-0001

County Pratt
NE. NE. SW. Sec. 17 Twp. 26S Rge. 15 XX East West

2310. Ft North from Southeast Corner of Section
2970. Ft West from Southeast Corner of Section
(Note: Locate well in section plat below)


Lease Name DOGGETT Well # 11

Field Name HODAVALL POOL

Producing Formation LAWAING-KC. 'H'

Elevation: Ground 2041' KB. 2046'

Section Plat

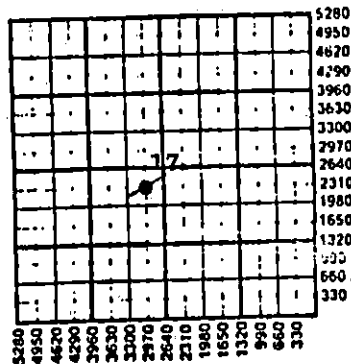

WATER SUPPLY INFORMATION

Disposition of Produced Water: X Disposal
Docket # Repressuring

So. Leitchburg/Stafford County
Questions on this portion of the ACO-1 call:
Water Resources Board (913) 296-3717

Source of Water:
Division of Water Resources Permit #

Groundwater: Ft North from Southeast Corner (Well)
Ft West from Southeast Corner of Sec Twp Rge East West

Surface Water: Ft North from Southeast Corner (Stream, pond etc.)
Ft West from Southeast Corner Sec Twp Rge East West

Other (explain) (purchased from city, R.W.D. #)

INSTRUCTIONS: This form shall be completed in duplicate and filed with the Kansas Corporation Commission, 200 Colorado Derby Building, Wichita, Kansas 67202, within 90 days after completion or recompletion of any well. Rule 82-3-130 and 82-3-107 apply.
Information on side two of this form will be held confidential for a period of 12 months if requested in writing and submitted with the form. See rule 82-3-107 for confidentiality in excess of 12 months.
One copy of all wireline logs and drillers time log shall be attached with this form. Submit CP-4 form with all plugged wells. Submit CP-111 form with all temporarily abandoned wells.

All requirements of the statutes, rules and regulations promulgated to regulate the oil and gas industry have been fully complied with and the statements herein are complete and correct to the best of my knowledge.

Signature Paul M. Gunzelman

Title Geologist Kansas Div. Date 9/30/87

Subscribed and sworn to before me this 30th day of September 1987.

Notary Public Patricia L. Ungleich

Date Commission Expires March 27, 1991

K.C.C. OFFICE USE ONLY

F Letter of Confidentiality Attached

C Wireline Log Received

C Drillers Time Log Received

Distribution
KCC SWD/Rep NGPA
KGS Plug Other (Specify)

RECEIVED

Form ACO-1 (7-84)

12-20-93

DEC 20 1993

CONSERVATION